

NOTES

1. This survey of ADL 231706 and ADL 232974 was accomplished in accordance with AS 38.05.810(e) and P&C SI 2017-66.
2. ASLS 2017-66 (ADL 231706) encompasses facilities of the Allison Creek Hydroelectric System (dam, penstock, power plant, access road and transmission line). Portions of the power plant and other hydroelectric facilities lie within leased Alyeska Terminal lands (USS 3328). The project electric transmission line (T-line) begins at the power plant and exits ASLS 2017-66 to the east. Design surveys, construction surveys and asbuilt surveys for these facilities began in September 2008 and continued until the final boundary survey in September 2019. Reference Federal Energy Regulatory Commission (FERC) Project No. 13124. Reference ADL 231698 T-line asbuilt (surveyed concurrently).
3. ADL 232974 Private non-exclusive access easement (PNAE): Access to Allison Creek Hydroelectric facilities begins at the intersection of Dayville Road and Granby Road (DNR RST 88), then follows Granby Road easterly to the Trans Alaska Pipeline System (TAPS) corridor (Tract A, T9S, R6W), then continues westerly along the TAPS corridor within PNAE ADL 232974 until it enters USS 3328, then continues southerly through USS 3328 and a private easement until it briefly enters ASLS 2017-66, then continues southerly through State lands in and out of ASLS 2017-66 until ending at the Allison Creek diversion dam. PNAE ADL 232974 is not necessary inside ASLS 2017-66 and therefore exists only in State lands outside ASLS 2017-66. PNAE ADL 232974 is under "interim" status until the filing of ASLS 2017-66, at which time the PNAE dedication will be issued and referenced to dimensions reported on the ASLS 2017-66 plat.
4. All bearings shown are true bearings as oriented to the Basis of Bearing and distances are reduced to horizontal field distances.
5. The error of closure of this survey does not exceed 1:5000.
4. Geographic and state plane coordinates shown here are NAD83(2007) based on GPS ties to NGS Station POWER. Station POWER is a 3.5" USC&GS brass disc set in bedrock below the MHW line of Valdez Arm just west of the Solomon Gulch Fish Hatchery. This project began in 2008 when the current NGS adjustment was NAD83(2007). This datum was held throughout the project timeline for the sake of consistency between project recorded documents and FERC filings. Station POWER NAD83(2007) coordinates were held in a minimally constrained GPS static network performed in 2008. All ensuing surveys through 2019 were constrained to this original GPS network. Reference Station POWER, NGS PID No. UV3926.
5. Protracted section corners are placed here per translation from NAD27 to NAD83(2007) using NGS Geodetic Toolkit NCAT program. Record NAD27 protraction coordinates for section corner 19/20/30/29 were converted to NAD83(2007). The entire NAD27 protraction for T9S, R6W was shifted to this NAD83(2007) position. This was a translation (move) only. Small variances in bearing and scale were ignored. Section lines intersecting ASLS 2017-66 are protracted except for those connecting to the west township line which was retraced and proportioned. Once the datum translation was made, NAD83(2007) protracted values were rotated to the ASLS 2017-66 basis of bearing and scaled (1/0.999870) to ground distances.

PLAT APPROVAL

I HEREBY CERTIFY THAT THIS PLAT HAS BEEN APPROVED BY THE CITY OF VALDEZ PLANNING AND ZONING COMMISSION FOR RECORDING.

JESS GONDEK
CHAIR OF THE PLANNING AND ZONING COMMISSION
CITY OF VALDEZ, ALASKA

DATE

LEGEND

- ▲ GEODETIC CONTROL MONUMENT RECOVERED
⊕ BLM MONUMENT RECOVERED
⊕ PRIMARY MONUMENT RECOVERED
● SECONDARY MONUMENT OF RECORD
⊕ PRIMARY MONUMENT SET THIS SURVEY

— UNSURVEYED

— SURVEYED

— EASEMENT

----- ADL 232974 EASEMENT

..... TOE OF FILL, TOP OF CUT, EDGE OF TEMPORARY CONSTRUCTION PAD, STAGING AREA, ETC.



- R1 RECORD PER NGS PID UV3926
R2 RECORD PER BLM
R3 RECORD PER ASLS 74-83
R4 RECORD PER ASLS 79-118
R5 RECORD PER RS2477 PLAT 2015-9, VRD
R6 RECORD PER TAPS PLAT 88-1, VRD




SURVEYOR'S CERTIFICATE

I, RANDAL H. BRINKER, HEREBY CERTIFY THAT I AM PROPERLY REGISTERED AND LICENSED TO PRACTICE LAND SURVEYING IN THE STATE OF ALASKA, THAT THIS PLAT REPRESENTS A SURVEY MADE BY ME OR UNDER MY DIRECT SUPERVISION, THAT THE MONUMENTS SHOWN HEREON ACTUALLY EXIST AS DESCRIBED, AND THAT ALL DIMENSIONS AND OTHER DETAILS ARE CORRECT.

REGISTERED LAND SURVEYOR, PLS # DATE

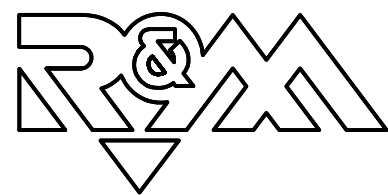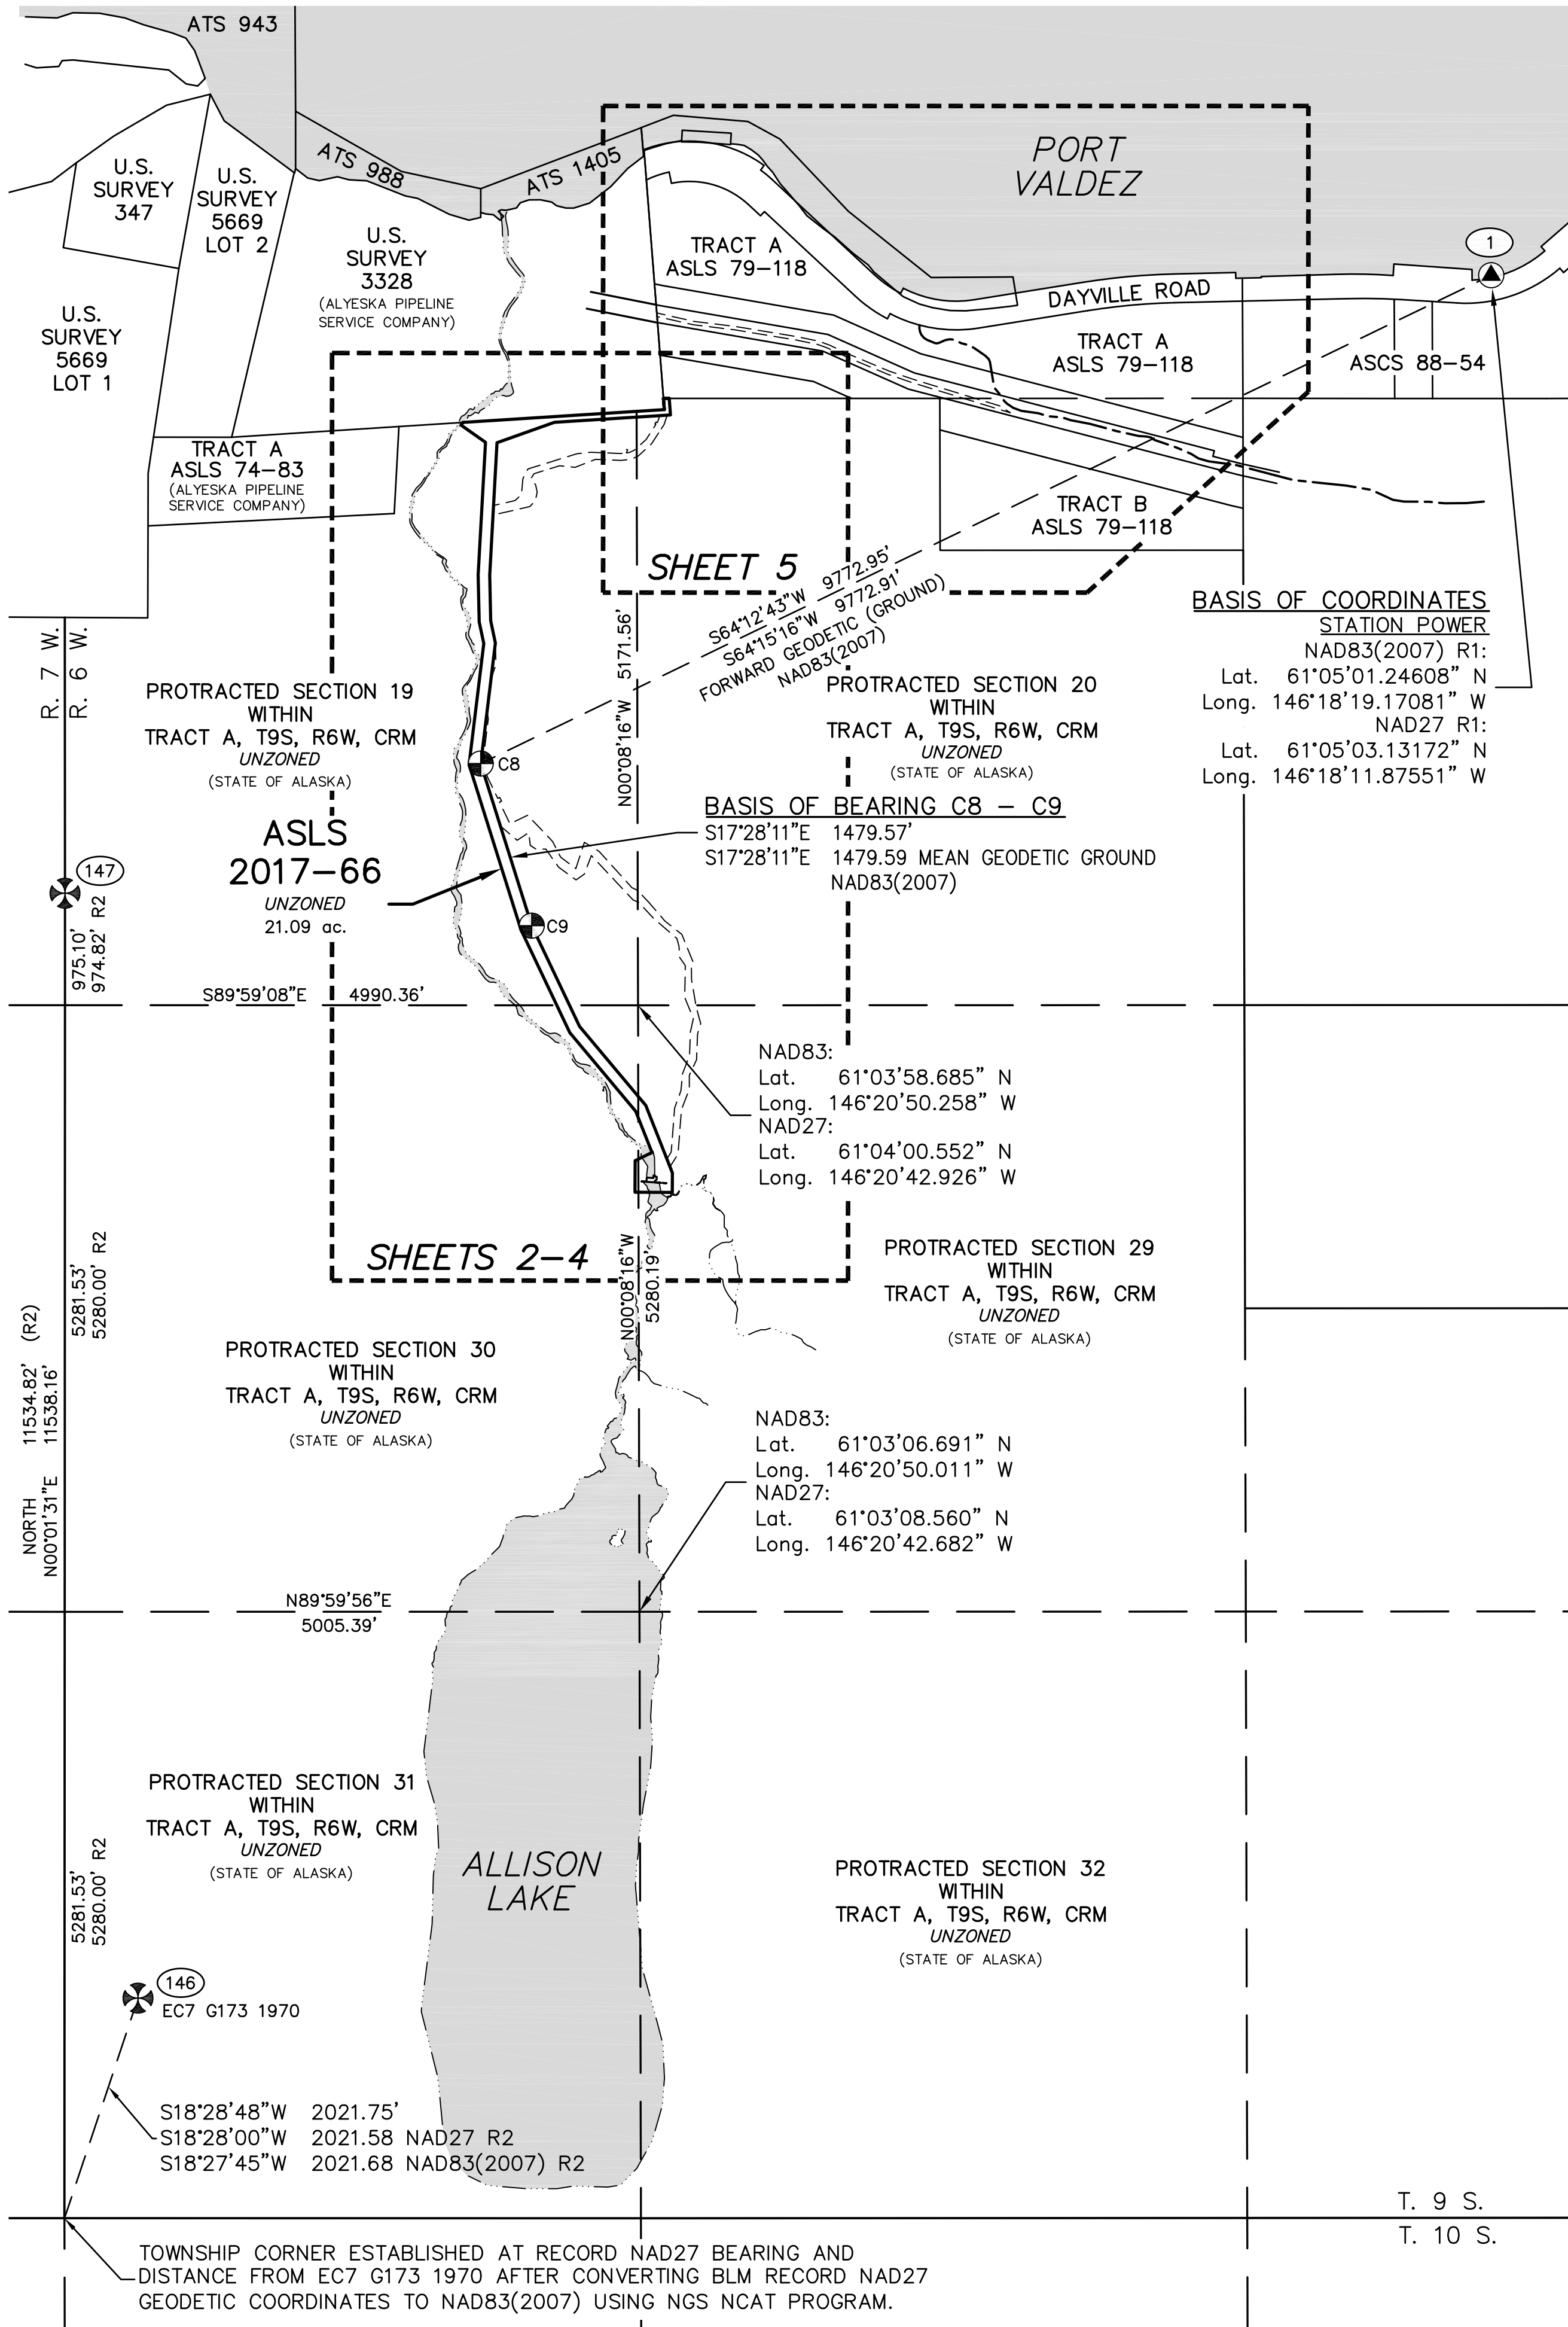

MAGNETIC DECLINATION = 16° 57' E
ANNUAL CHANGE = 0° 14' WEST PER YEAR
NOAA WMM-2020
DATE: 1/1/2020

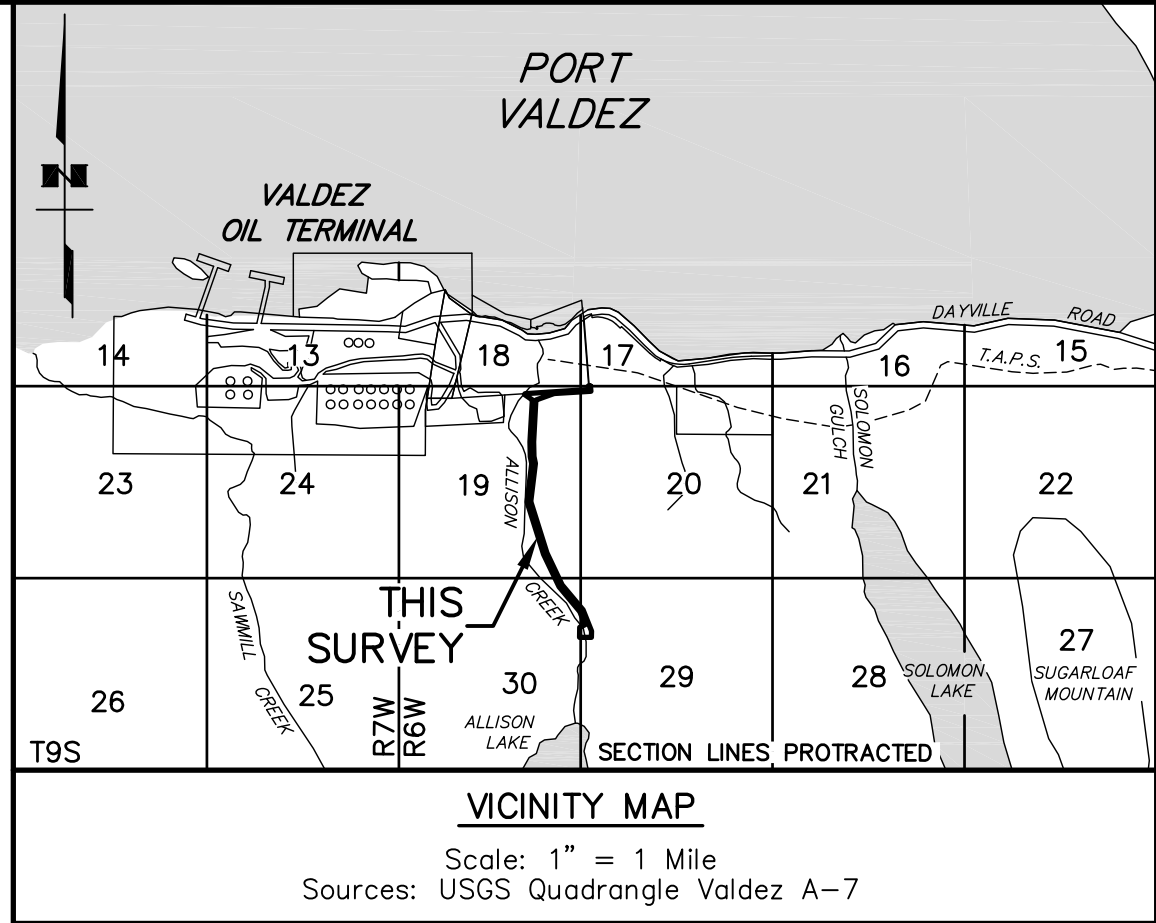

CERTIFICATE OF OWNERSHIP AND DEDICATION

I, THE UNDERSIGNED, HEREBY CERTIFY THAT I AM THE DIRECTOR, DIVISION OF MINING, LAND AND WATER, AND THAT THE STATE OF ALASKA IS THE OWNER OF ASLS NO. 2017-66 AS SHOWN HEREON. I HEREBY APPROVE THIS SURVEY AND PLAT FOR THE STATE OF ALASKA, AND DEDICATE FOR PUBLIC OR PRIVATE USE AS NOTED, ALL EASEMENTS, PUBLIC UTILITY AREAS, AND RIGHTS-OF-WAY AS SHOWN AND DESCRIBED HEREON.

DATE DIRECTOR, DIVISION OF MINING, LAND AND WATER

NOTARY'S ACKNOWLEDGEMENT

SUBSCRIBED AND SWORN TO BEFORE ME THIS _____ DAY OF _____, 2020, BY: _____

NOTARY FOR THE STATE OF ALASKA
MY COMMISSION EXPIRES: _____

APPLICANT CERTIFICATE

I, THE UNDERSIGNED, HEREBY CERTIFY THAT I AM THE APPLICANT AS SHOWN HEREON. I HEREBY APPROVE THIS SURVEY AND PLAT.

ADL NO. 231706 TRAVIS MILLION DATE
ADL NO. 232974 PO BOX 45 GLENNALLEN, ALASKA 99588

NOTARY'S ACKNOWLEDGEMENT

SUBSCRIBED AND SWORN TO BEFORE ME THIS _____ DAY OF _____, 2020, BY: _____

NOTARY FOR THE STATE OF ALASKA
MY COMMISSION EXPIRES: _____

TAX CERTIFICATE

THIS SUBDIVISION IS NOT SUBJECT TO TAXATION, AT THE TIME OF FILING.

GRAPHIC SCALE
0 500 1000 2000 3000 4000 FEET
0 100 200 300 400 500 1000 1500 METERS
1 METER = 3.280833 U.S. SURVEY FEET AND 1 U.S.ACRE = 0.4047 HECTARE






DATE OF SURVEY: BEGINNING: SEPT. 2008 ENDING: SEPT. 2019
SURVEYOR: R & M CONSULTANTS, INC. 9101 VANGUARD DRIVE, ANCHORAGE, AK 99507 907-522-1707 VOICE, 907-522-3404 FAX WWW.RMCONSULT.COM COA# AECC111

STATE OF ALASKA
DEPARTMENT OF NATURAL RESOURCES
DIVISION OF MINING, LAND, AND WATER
ANCHORAGE, ALASKA

ALASKA STATE LAND SURVEY No. 2017-66

A SUBDIVISION OF TRACT A AND THE DEPICTION OF ADL NO. 232974, A PRIVATE NON-EXCLUSIVE ACCESS EASEMENT LOCATED WITHIN PROTRACTED SECTIONS 17, 19, 20, 29 & 30 of TRACT A, TOWNSHIP 9 SOUTH, RANGE 6 WEST, COPPER RIVER MERIDIAN, ALASKA CONTAINING 21.09 ACRES VALDEZ RECORDING DISTRICT


DRAWN BY: RHB APPROVAL RECOMMENDED
DATE: MARCH 6, 2020 STATEWIDE PLATTING SUPERVISOR DATE:
SCALE: 1"=1000' CHECKED: RHB SHEET: 1 OF 6 DNR FILE NO. ASLS 20170066

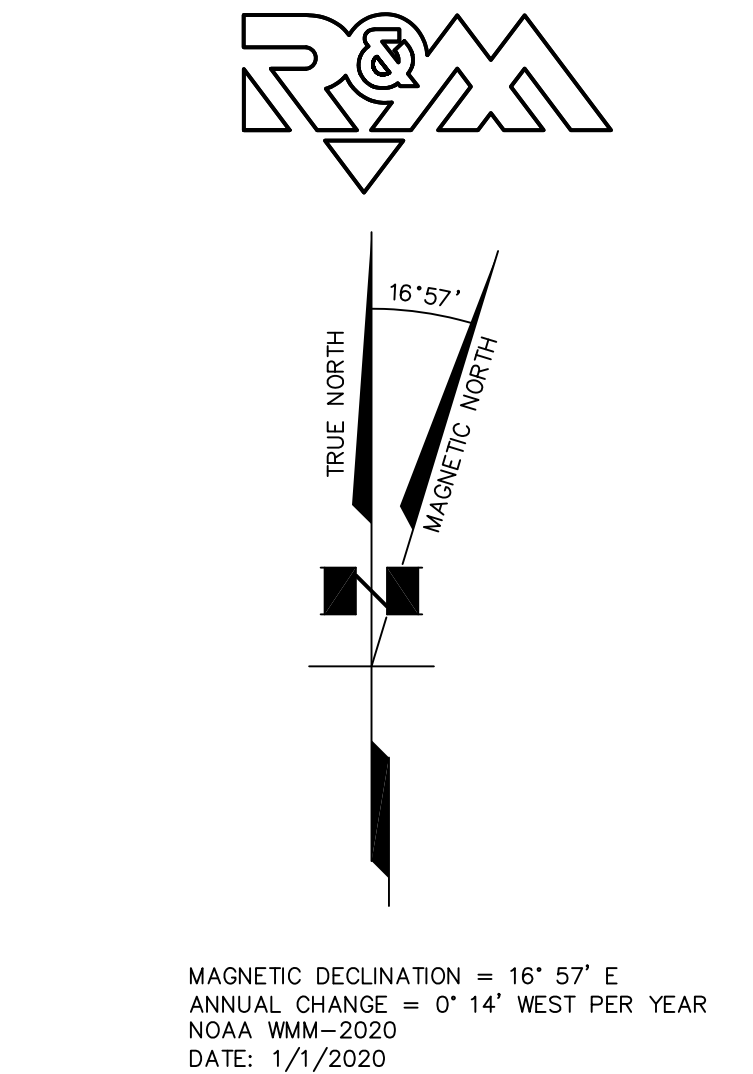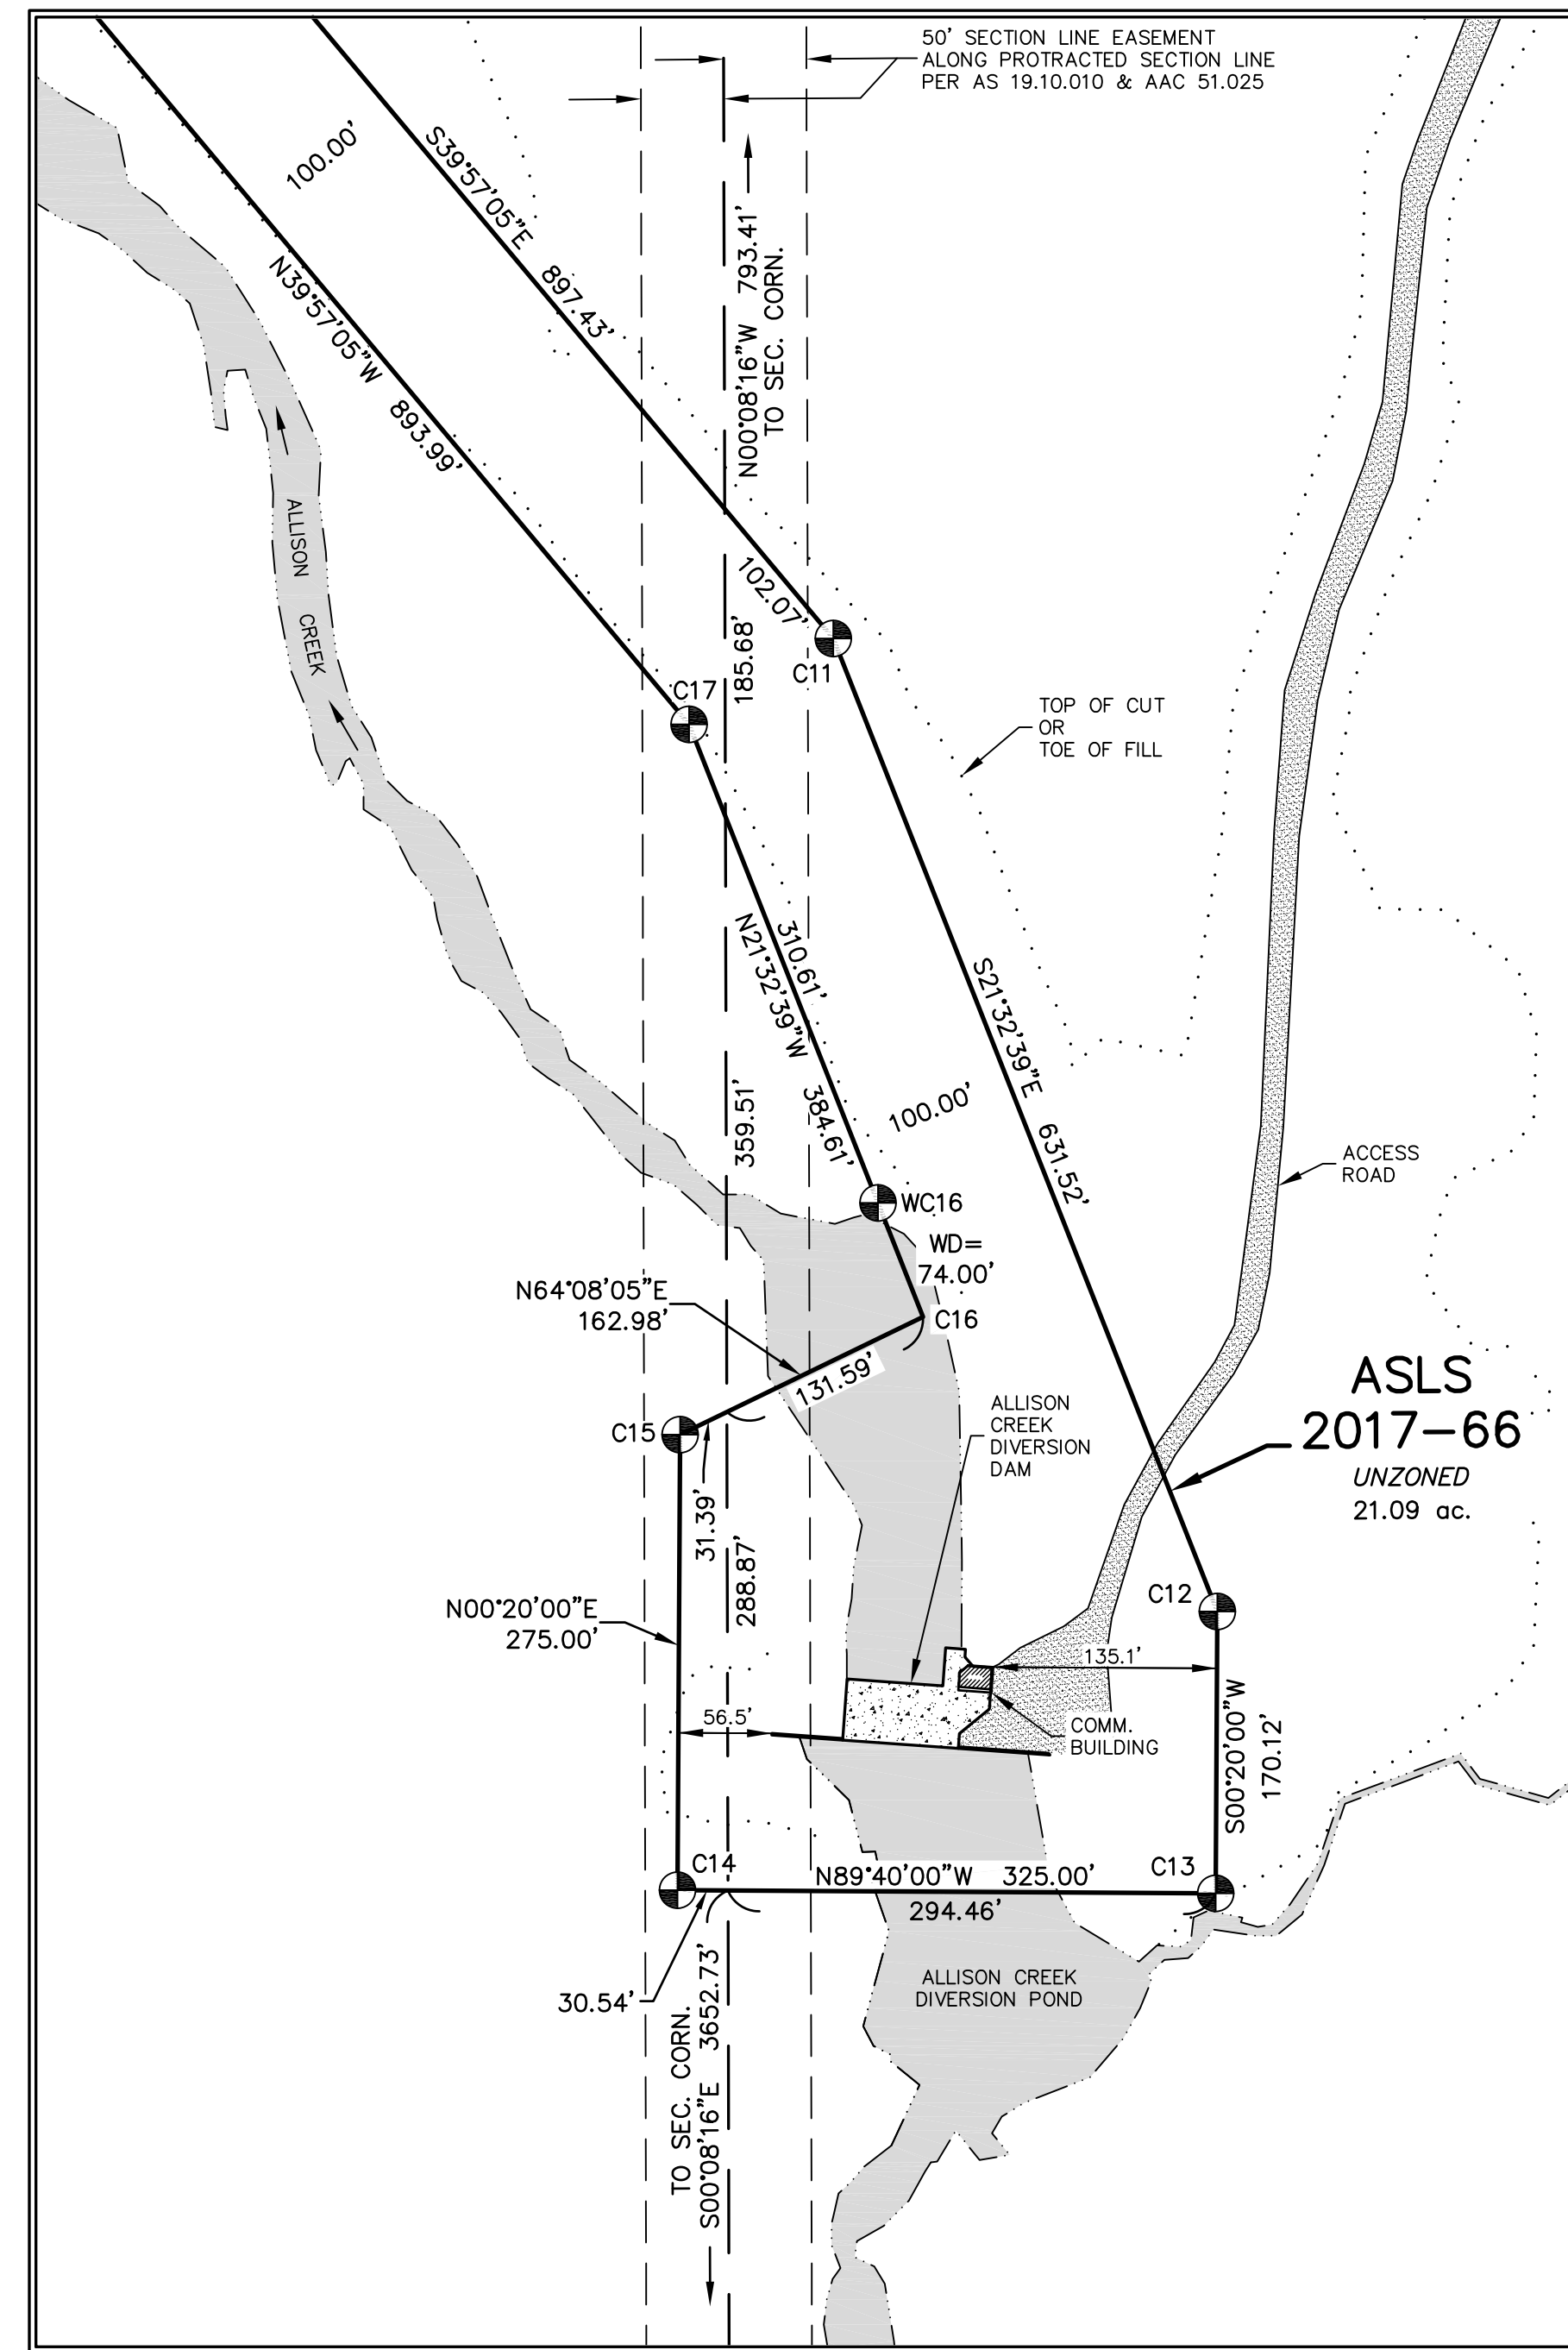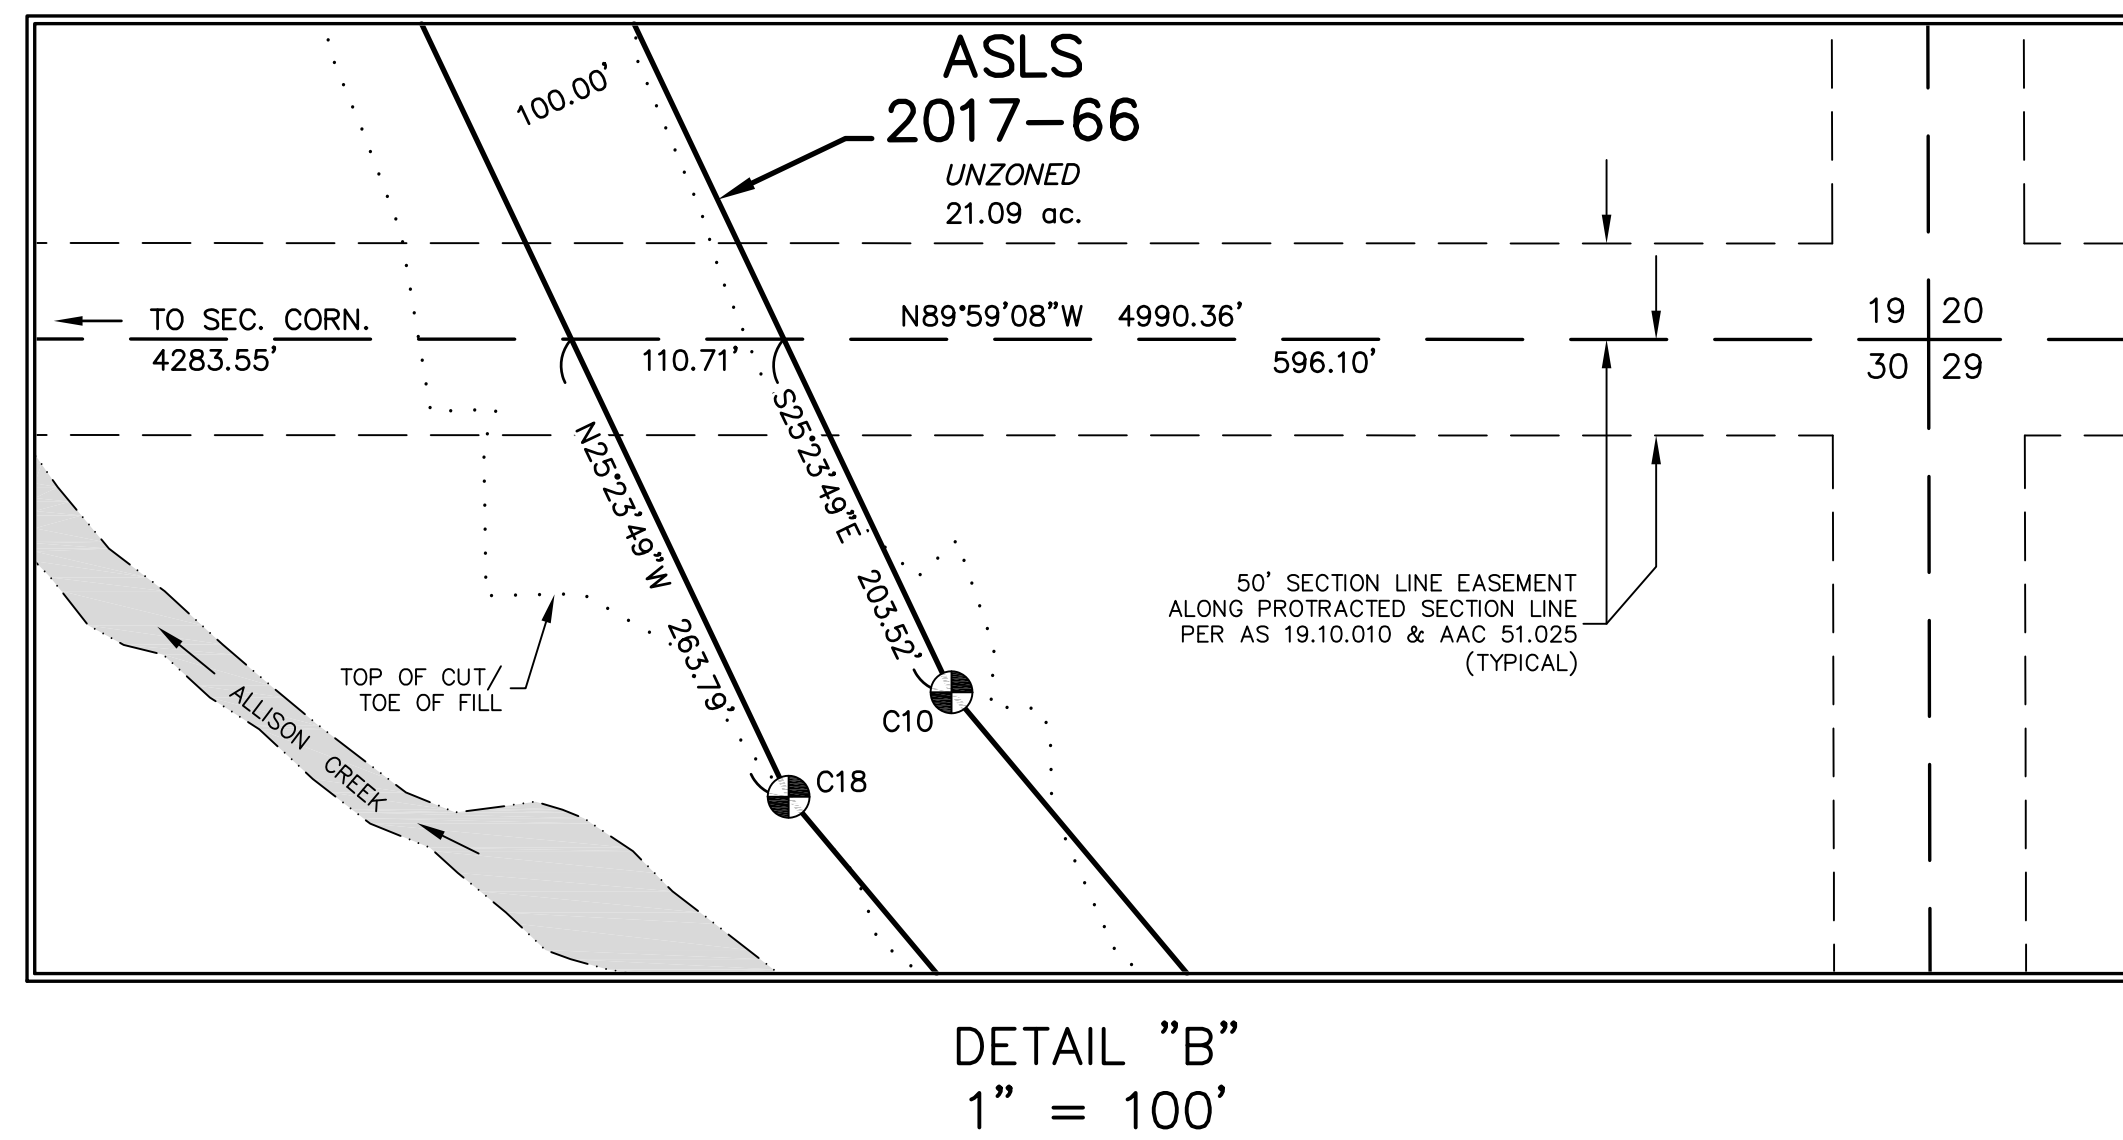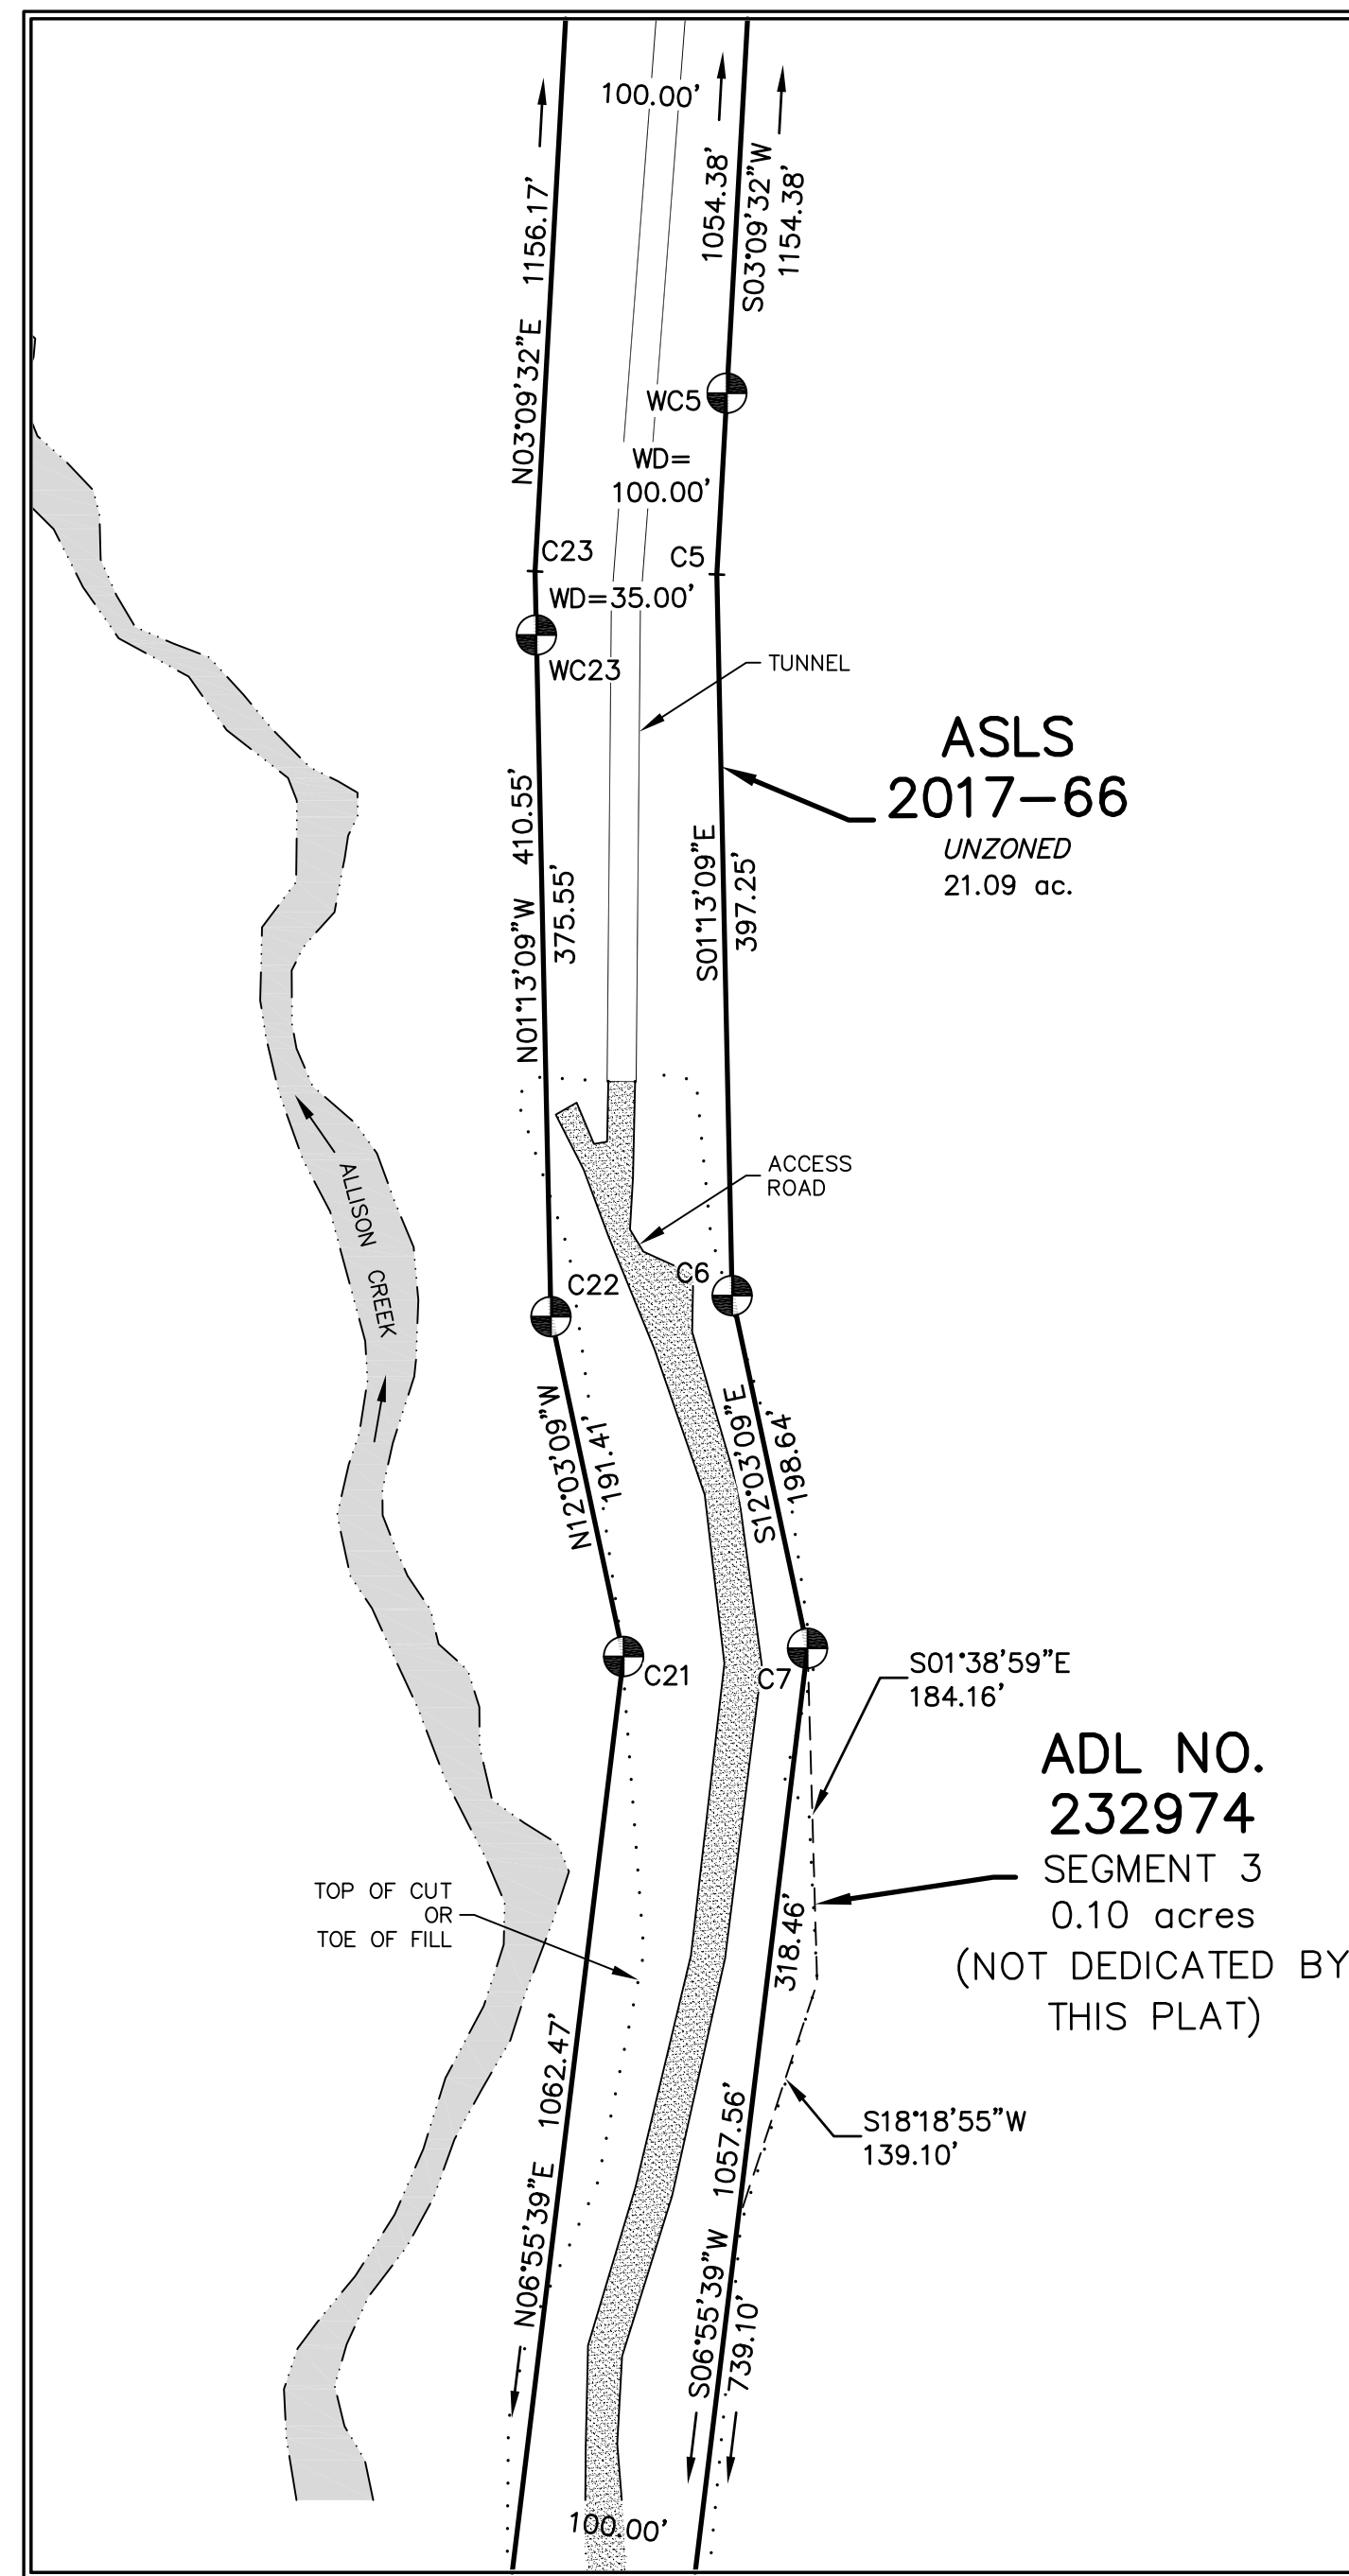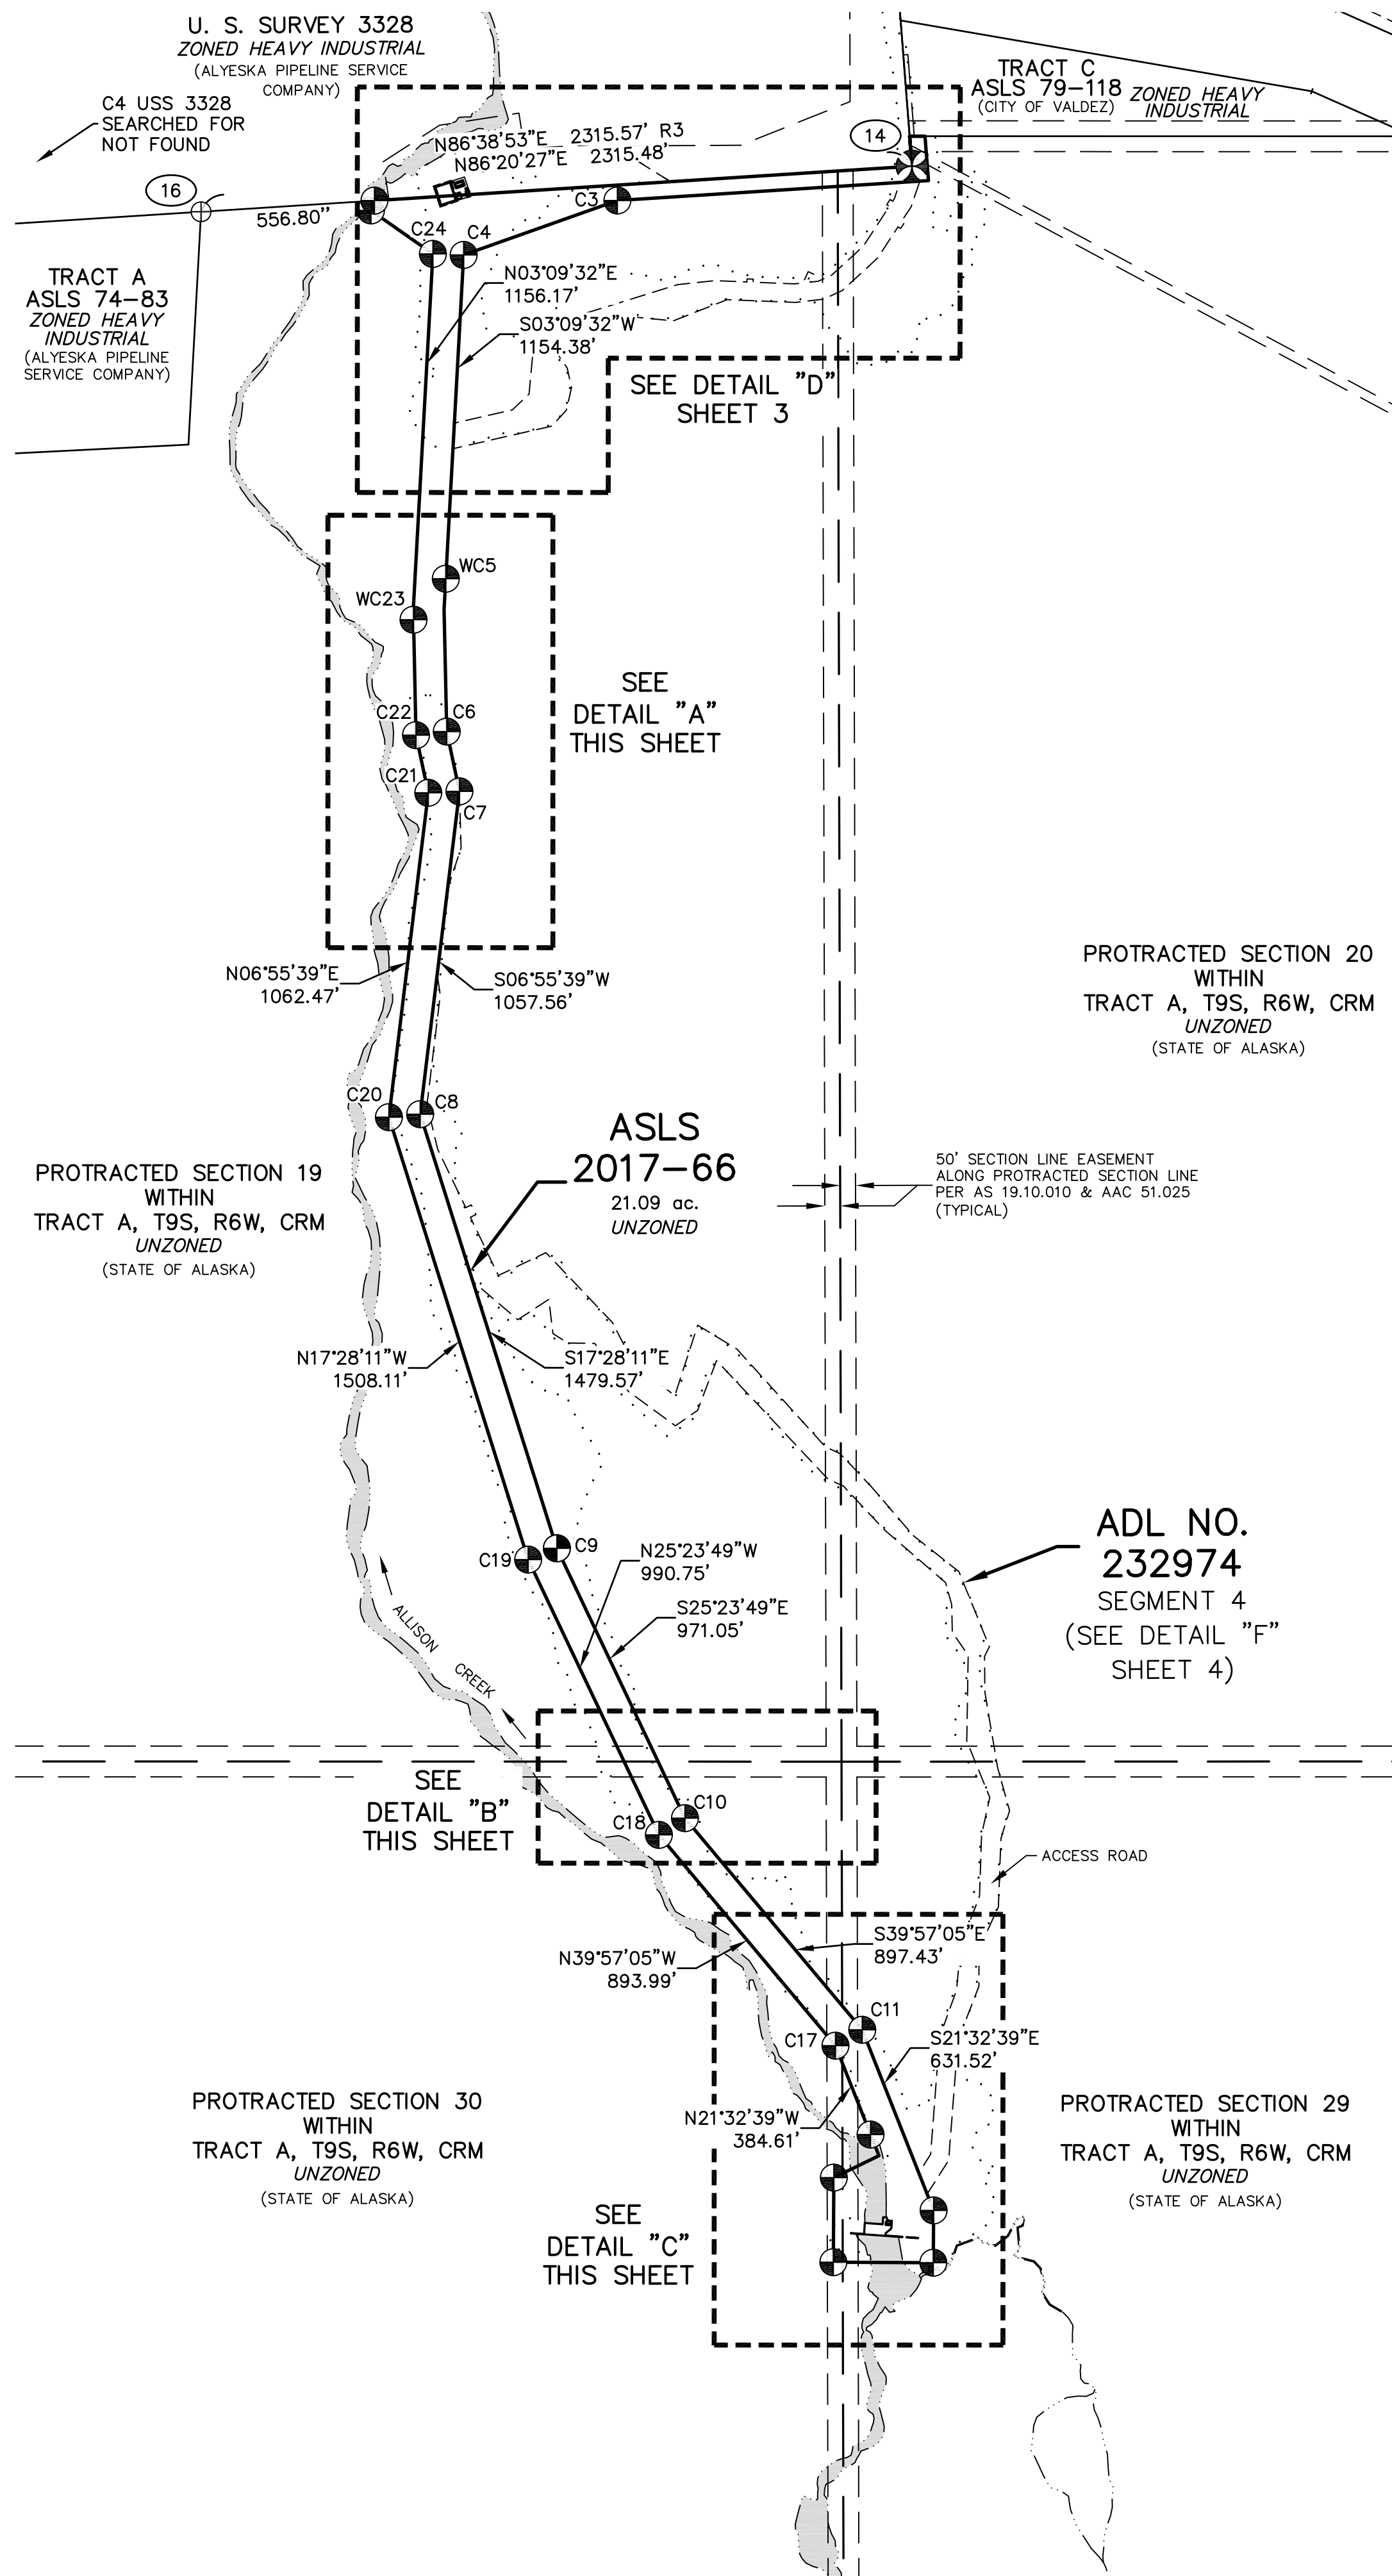


- LEGEND**
- BLM MONUMENT RECOVERED
 - PRIMARY MONUMENT RECOVERED
 - PRIMARY MONUMENT SET THIS SURVEY
 - UNSURVEYED
 - SURVEYED
 - EASEMENT
 - ADL 232974 EASEMENT
 - TOE OF FILL, TOP OF CUT, EDGE OF TEMPORARY CONSTRUCTION PAD, STAGING AREA, ETC.
 - R3 RECORD PER ASLS 74-83

GRAPHIC SCALE
0 200 400 800 1200 1600 FEET
0 40 80 120 160 200 400 600 METERS
1 METER = 3.280833 U.S. SURVEY FEET AND 1 U.S.ACRE = 0.4047 HECTARE

DATE OF SURVEY: BEGINNING: SEPT. 2008 ENDING: SEPT. 2019	SURVEYOR: R & M CONSULTANTS, INC. 9101 VANGUARD DRIVE, ANCHORAGE, AK 99507 907-522-1707 VOICE, 907-522-3404 FAX WWW.RMCONSULT.COM COA# AECC111
STATE OF ALASKA DEPARTMENT OF NATURAL RESOURCES DIVISION OF MINING, LAND, AND WATER ANCHORAGE, ALASKA	
ALASKA STATE LAND SURVEY No. 2017-66	
A SUBDIVISION OF TRACT A AND THE DEPICTION OF ADL NO. 232974, A PRIVATE NON-EXCLUSIVE ACCESS EASEMENT LOCATED WITHIN PROTRACTED SECTIONS 17, 19, 20, 29 & 30 of TRACT A, TOWNSHIP 9 SOUTH, RANGE 6 WEST, COPPER RIVER MERIDIAN, ALASKA CONTAINING 21.09 ACRES VALDEZ RECORDING DISTRICT	
DRAWN BY: RHB DATE: MARCH 6, 2020	APPROVAL RECOMMENDED STATEWIDE PLATTING SUPERVISOR DATE:
SCALE: 1"=400'	CHECKED: RHB SHEET: 2 OF 6 DNR FILE NO. ASLS 20170066

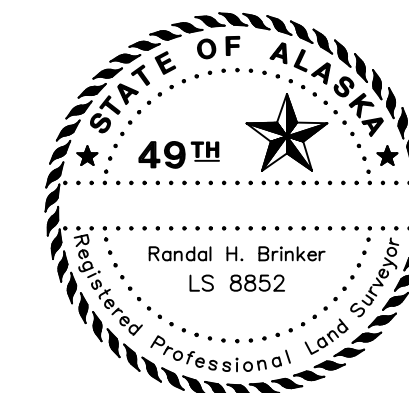

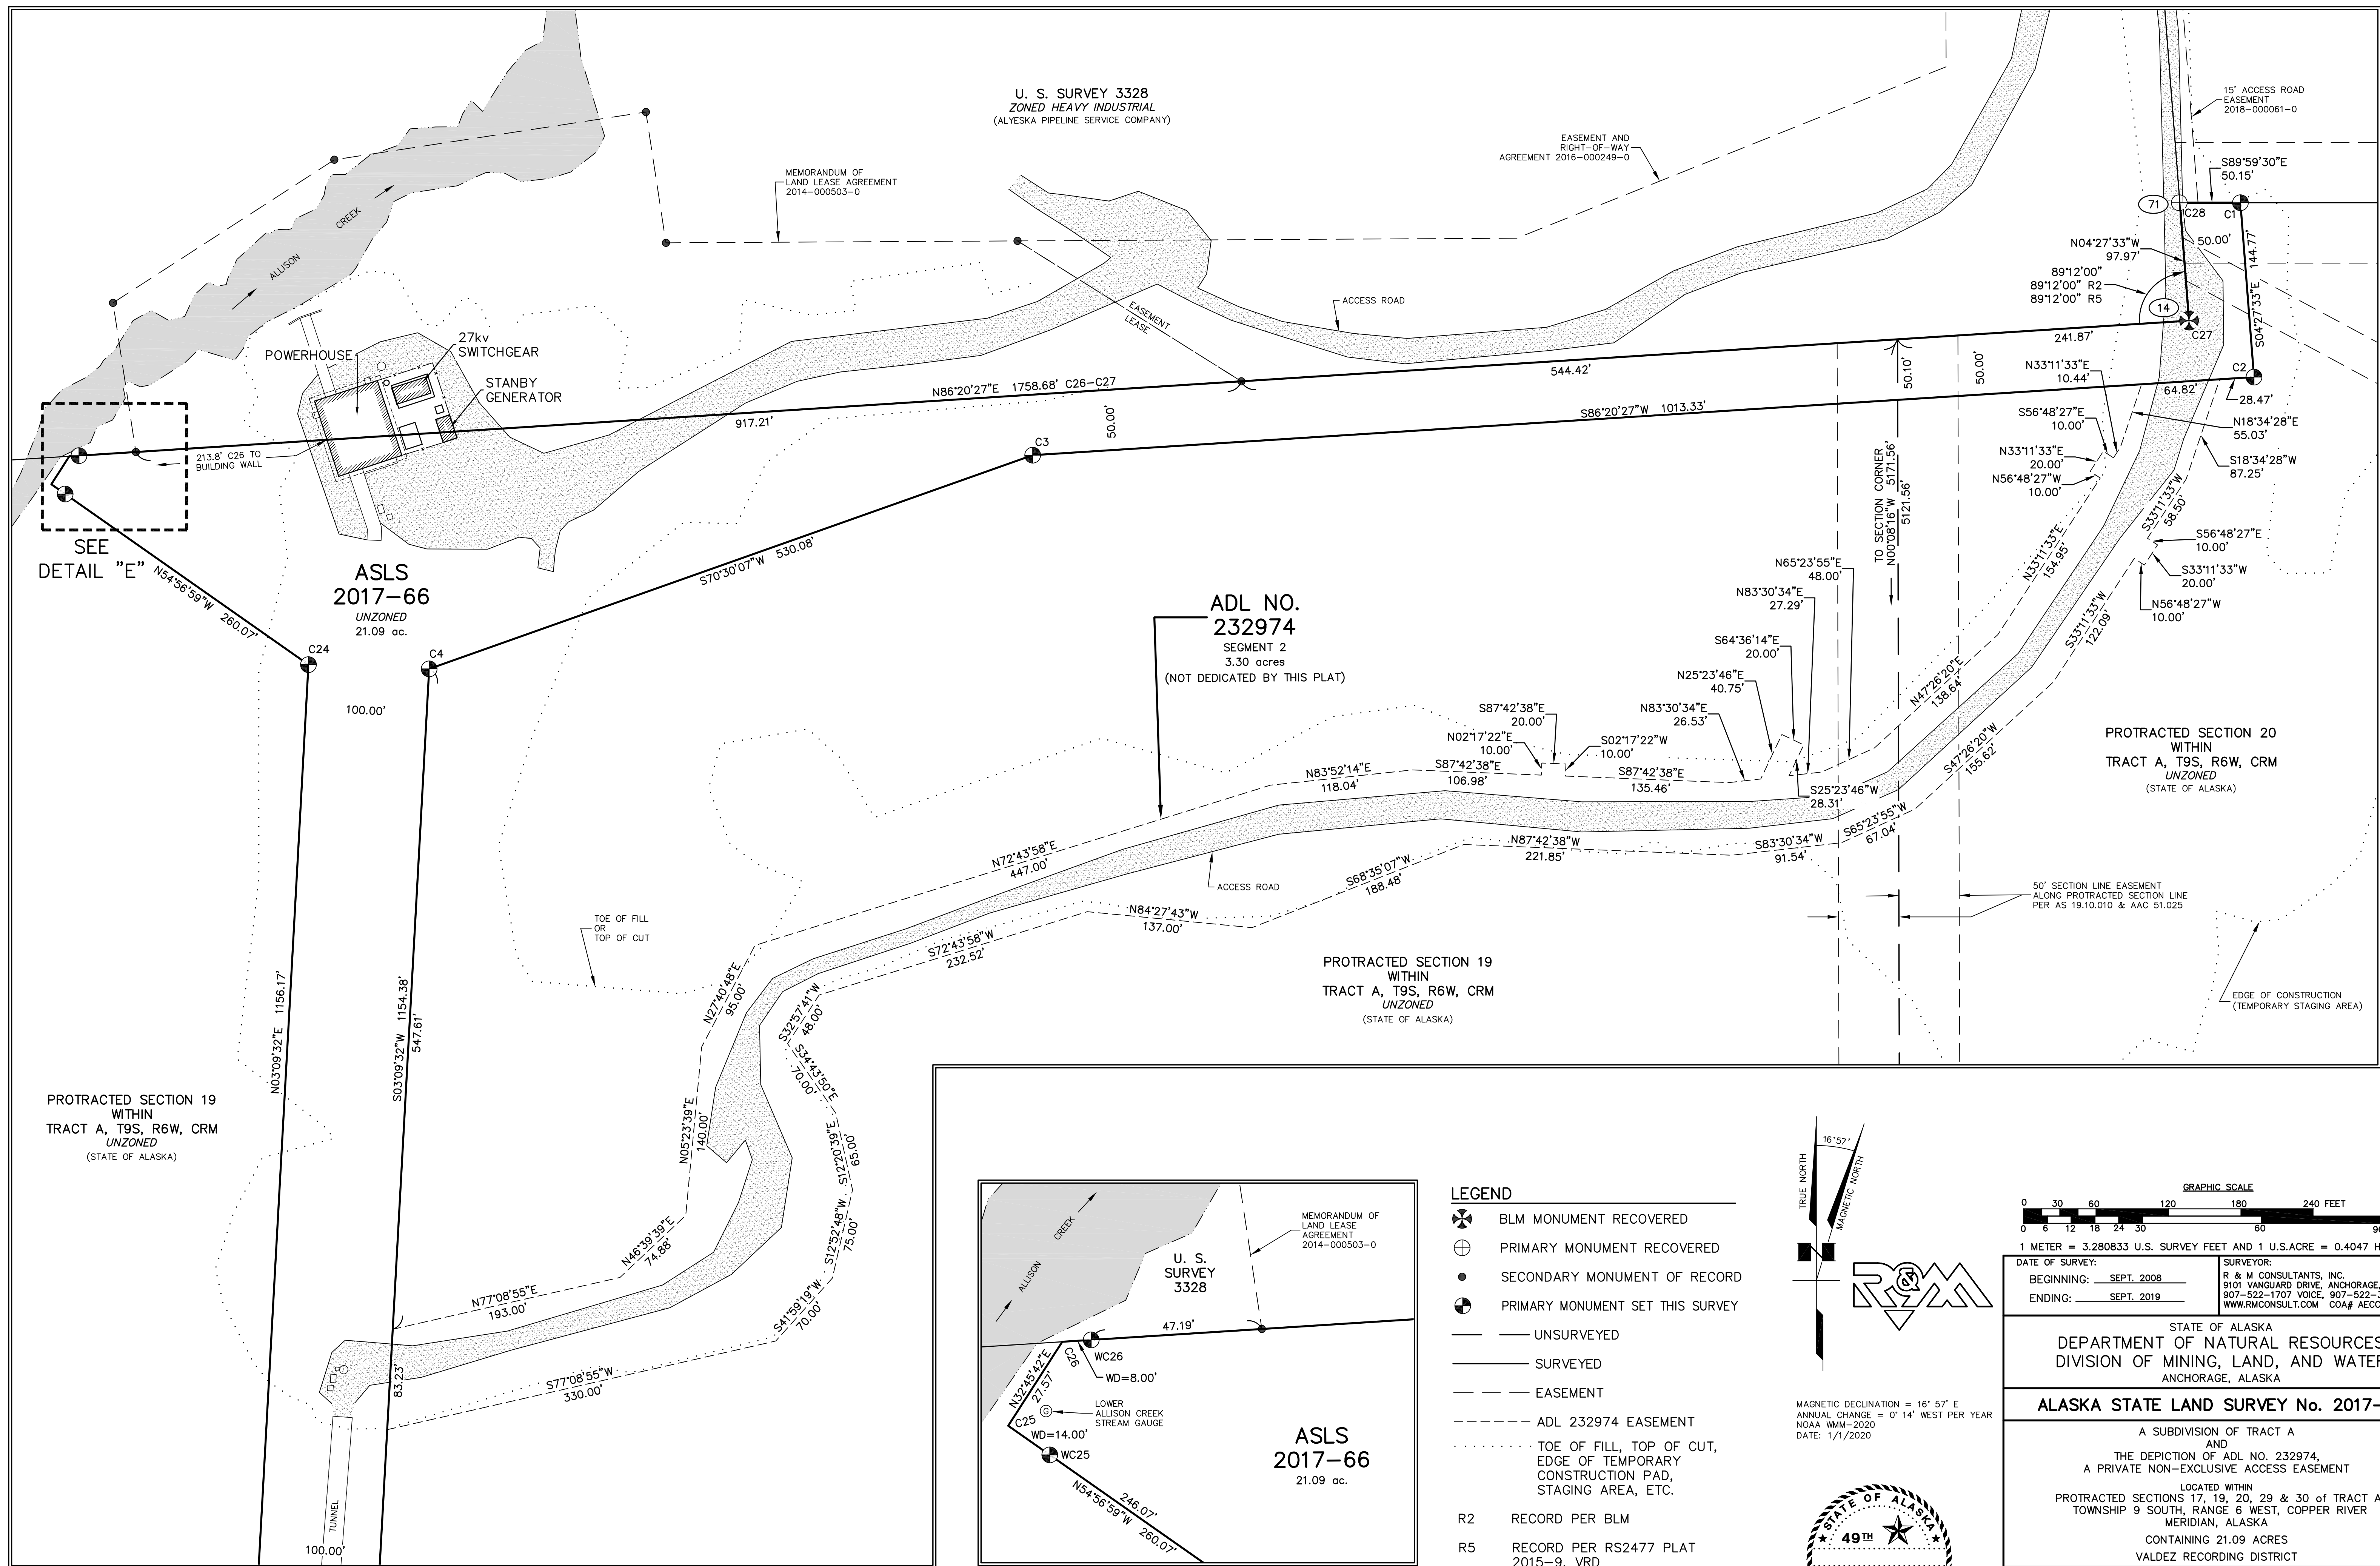


PROTRACTED SECTION 19
WITHIN
TRACT A, T9S, R6W, CRM
UNZONED
(STATE OF ALASKA)

ASLS
2017-66
UNZONED
21.09 ac.

ADL NO.
232974
SEGMENT 2
3.30 acres
(NOT DEDICATED BY THIS PLAT)

PROTRACTED SECTION 19
WITHIN
TRACT A, T9S, R6W, CRM
UNZONED
(STATE OF ALASKA)



PROTRACTED SECTION 20
WITHIN
TRACT A, T9S, R6W, CRM
UNZONED
(STATE OF ALASKA)

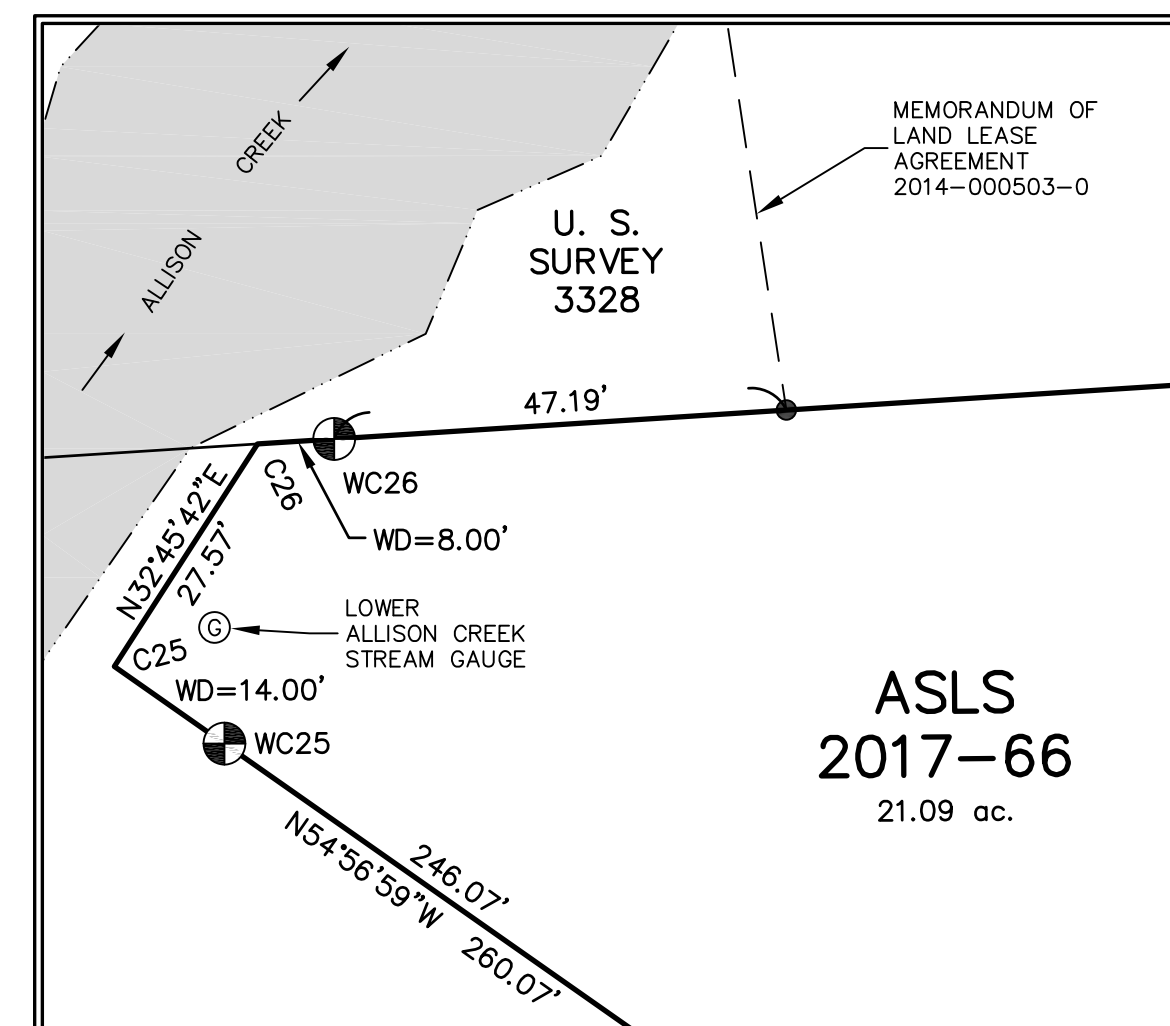

DETAIL "E"
1" = 20'

LEGEND

- BLM MONUMENT RECOVERED
- PRIMARY MONUMENT RECOVERED
- SECONDARY MONUMENT OF RECORD
- PRIMARY MONUMENT SET THIS SURVEY
- UNSURVEYED
- SURVEYED
- EASEMENT
- ADL 232974 EASEMENT
- TOE OF FILL, TOP OF CUT, EDGE OF TEMPORARY CONSTRUCTION PAD, STAGING AREA, ETC.
- R2 RECORD PER BLM
- R5 RECORD PER RS2477 PLAT 2015-9, VRD

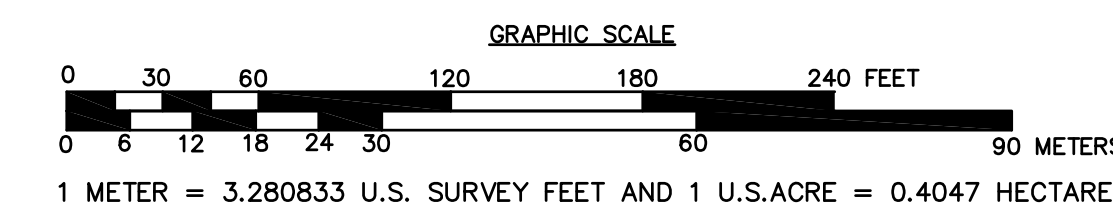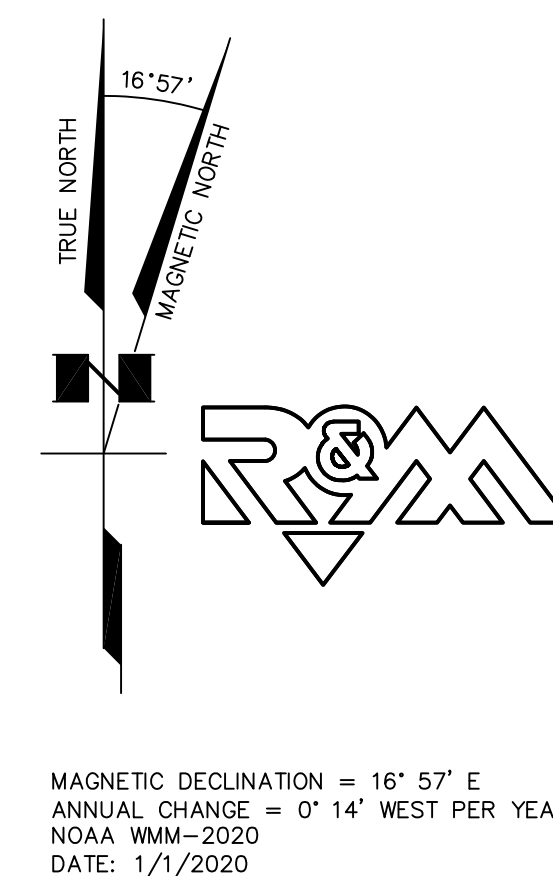


DATE OF SURVEY: _____
BEGINNING: SEPT. 2008
ENDING: SEPT. 2019
SURVEYOR:
R & M CONSULTANTS, INC.
9101 VANGUARD DRIVE, ANCHORAGE, AK 99507
907-522-1707 VOICE, 907-522-3404 FAX
WWW.RMCONSULT.COM COA# AECC111

STATE OF ALASKA
DEPARTMENT OF NATURAL RESOURCES
DIVISION OF MINING, LAND, AND WATER
ANCHORAGE, ALASKA



ALASKA STATE LAND SURVEY No. 2017-66

A SUBDIVISION OF TRACT A
AND
THE DEPICTION OF ADL NO. 232974,
A PRIVATE NON-EXCLUSIVE ACCESS EASEMENT
LOCATED WITHIN
PROTRACTED SECTIONS 17, 19, 20, 29 & 30 of TRACT A,
TOWNSHIP 9 SOUTH, RANGE 6 WEST, COPPER RIVER
MERIDIAN, ALASKA
CONTAINING 21.09 ACRES
VALDEZ RECORDING DISTRICT

DRAWN BY: RHB
DATE: MARCH 6, 2020
SCALE: 1"=60'
APPROVAL RECOMMENDED
STATEWIDE PLATTING SUPERVISOR
DATE: _____
CHECKED: RHB
SHEET: 3 OF 6
DNR FILE NO.
ASLS 20170066

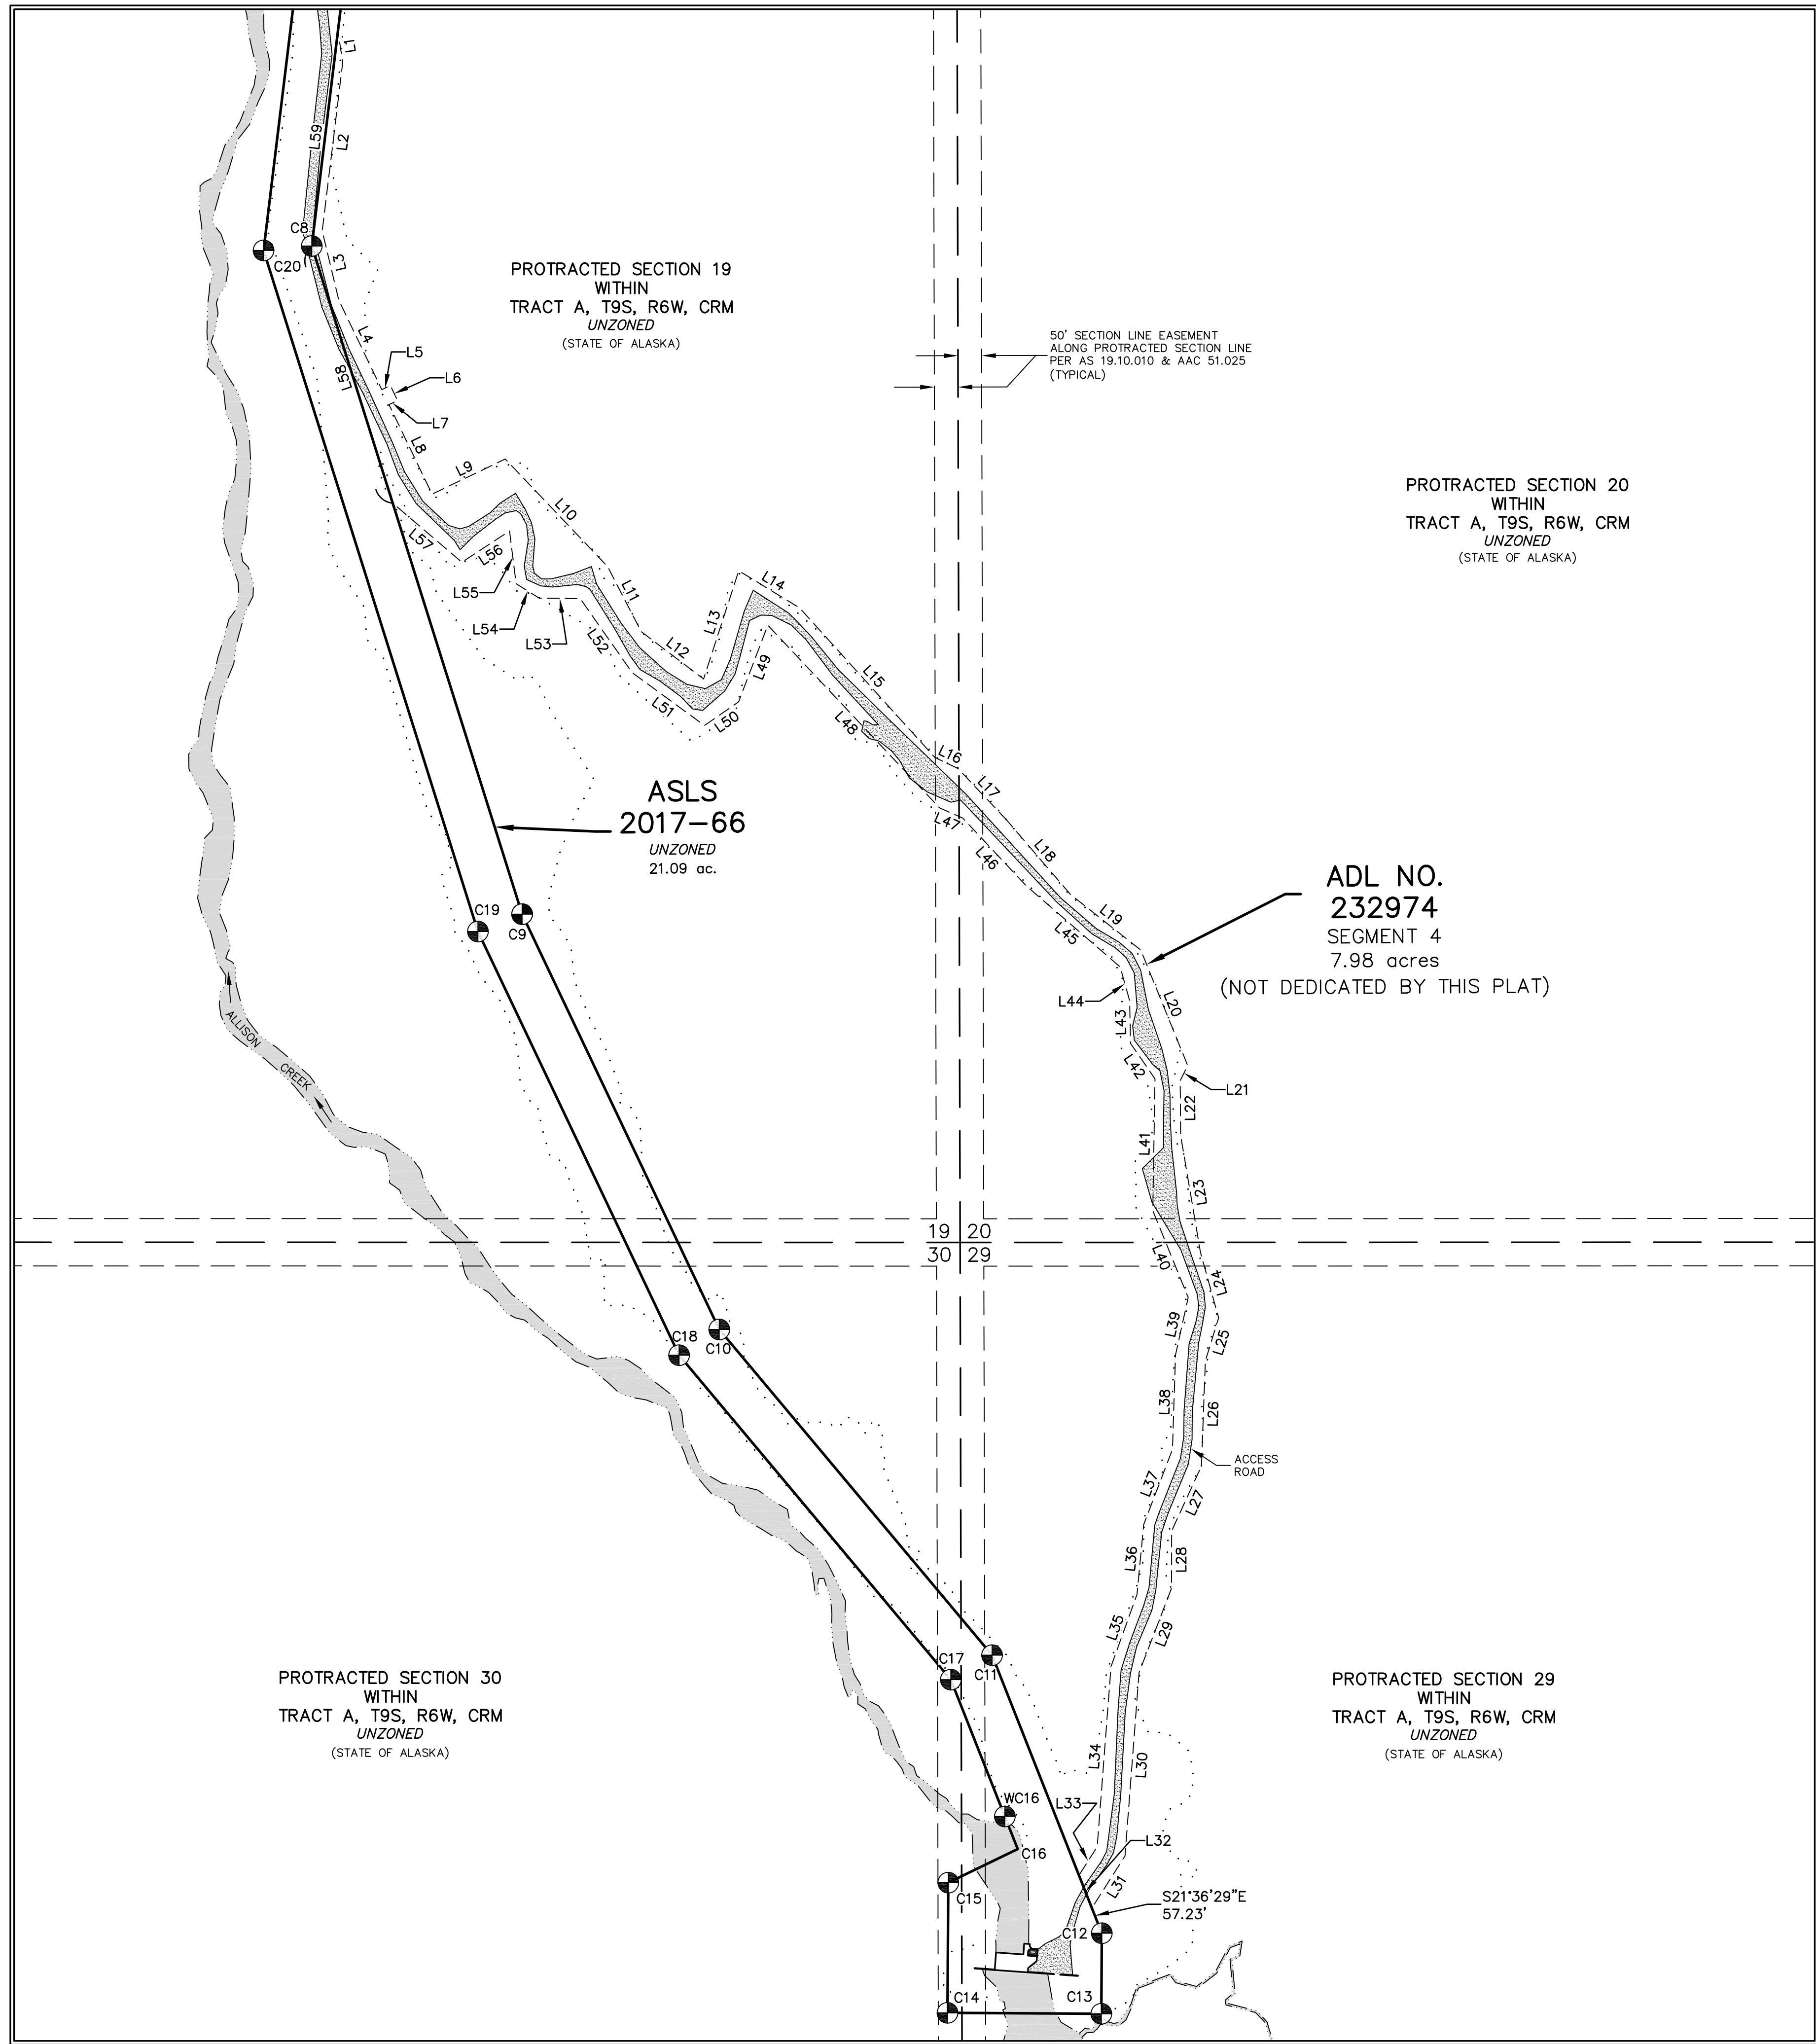


LINE TABLE		
LINE NO.	BEARING	LENGTH
L1	S08°29'58"E	67.67
L2	S06°55'39"W	358.12
L3	S13°27'01"E	150.00
L4	S25°40'28"E	210.00
L5	N64°19'32"E	20.00
L6	S25°40'28"E	35.00
L7	S64°19'32"W	20.00
L8	S25°40'28"E	210.00
L9	N64°19'32"E	171.49
L10	S43°34'31"E	313.66
L11	S27°21'14"E	154.75
L12	S52°47'56"E	165.36
L13	N18°00'24"E	240.41
L14	S58°34'29"E	150.35
L15	S42°08'26"E	426.25
L16	S64°30'14"E	53.89
L17	S43°23'17"E	148.12
L18	S40°37'41"E	208.63
L19	S51°38'21"E	189.58
L20	S22°07'40"E	263.17
L21	S26°32'10"W	35.38
L22	S00°26'56"E	115.84
L23	S09°35'35"E	250.28
L24	S15°33'24"E	143.94
L25	S17°11'28"W	94.84
L26	S02°08'55"W	222.83
L27	S24°41'04"W	150.95
L28	S00°00'44"W	120.53
L29	S21°04'13"W	191.06
L30	S04°23'23"W	388.76
L31	S32°30'27"W	130.28
L32	N21°32'39"W	74.13
L33	N32°30'27"E	71.73
L34	N04°23'23"E	381.86
L35	N19°48'22"E	161.96
L36	N05°27'06"E	148.24
L37	N20°56'55"E	169.83
L38	N01°52'44"E	199.54
L39	N12°24'59"E	124.32
L40	N22°08'29"W	198.15
L41	N00°56'40"E	278.55
L42	N34°38'56"W	90.81
L43	N01°19'15"W	90.78
L44	N15°37'50"W	73.40
L45	N49°10'27"W	262.78
L46	N43°07'57"W	195.76
L47	N66°27'27"W	53.17
L48	N43°14'16"W	529.95
L49	S20°50'37"W	173.27
L50	S55°16'10"W	87.71
L51	N53°49'09"W	189.08
L52	N35°05'07"W	190.99
L53	N89°14'56"W	86.75
L54	N57°57'28"W	57.45
L55	N07°09'50"W	112.19
L56	S56°45'54"W	120.31
L57	N49°29'31"W	192.13
L58	N17°28'11"W	569.39
L59	N06°55'39"E	457.55

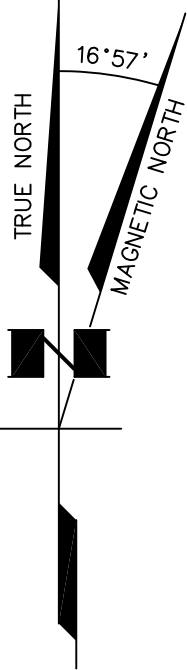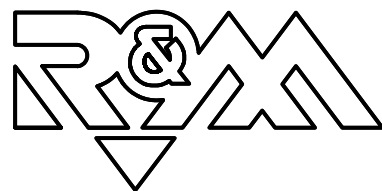

MAGNETIC DECLINATION = 16° 57' E
ANNUAL CHANGE = 0° 14' WEST PER YEAR
NOAA WMM-2020
DATE: 1/1/2020

- LEGEND**
- PRIMARY MONUMENT SET THIS SURVEY
 - UNSURVEYED
 - SURVEYED
 - EASEMENT
 - ADL 232974 EASEMENT
 - TOE OF FILL, TOP OF CUT, EDGE OF TEMPORARY CONSTRUCTION PAD, STAGING AREA, ETC.

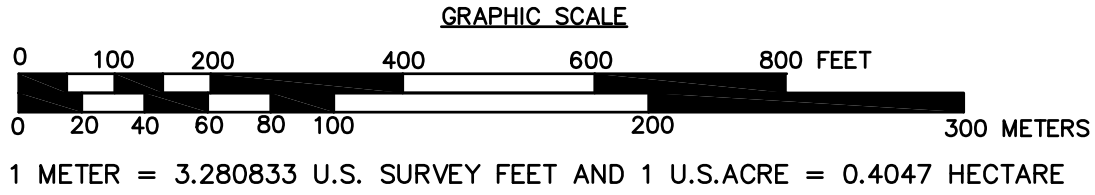

DATE OF SURVEY: BEGINNING: SEPT. 2008 ENDING: SEPT. 2019
SURVEYOR: R & M CONSULTANTS, INC. 9101 VANGUARD DRIVE, ANCHORAGE, AK 99507 907-522-1707 VOICE, 907-522-3404 FAX WWW.RMCONSULT.COM COA# AECC111


STATE OF ALASKA
DEPARTMENT OF NATURAL RESOURCES
DIVISION OF MINING, LAND, AND WATER
ANCHORAGE, ALASKA

ALASKA STATE LAND SURVEY No. 2017-66


A SUBDIVISION OF TRACT A
AND
THE DEPICTION OF ADL NO. 232974,
A PRIVATE NON-EXCLUSIVE ACCESS EASEMENT
LOCATED WITHIN
PROTRACTED SECTIONS 17, 19, 20, 29 & 30 of TRACT A,
TOWNSHIP 9 SOUTH, RANGE 6 WEST, COPPER RIVER
MERIDIAN, ALASKA
CONTAINING 21.09 ACRES
VALDEZ RECORDING DISTRICT

DRAWN BY: RHB APPROVAL RECOMMENDED
DATE: MARCH 6, 2020 STATEWIDE PLATTING SUPERVISOR DATE:
SCALE: 1"=200' CHECKED: RHB SHEET: 4 OF 6 DNR FILE NO. ASLS 20170066




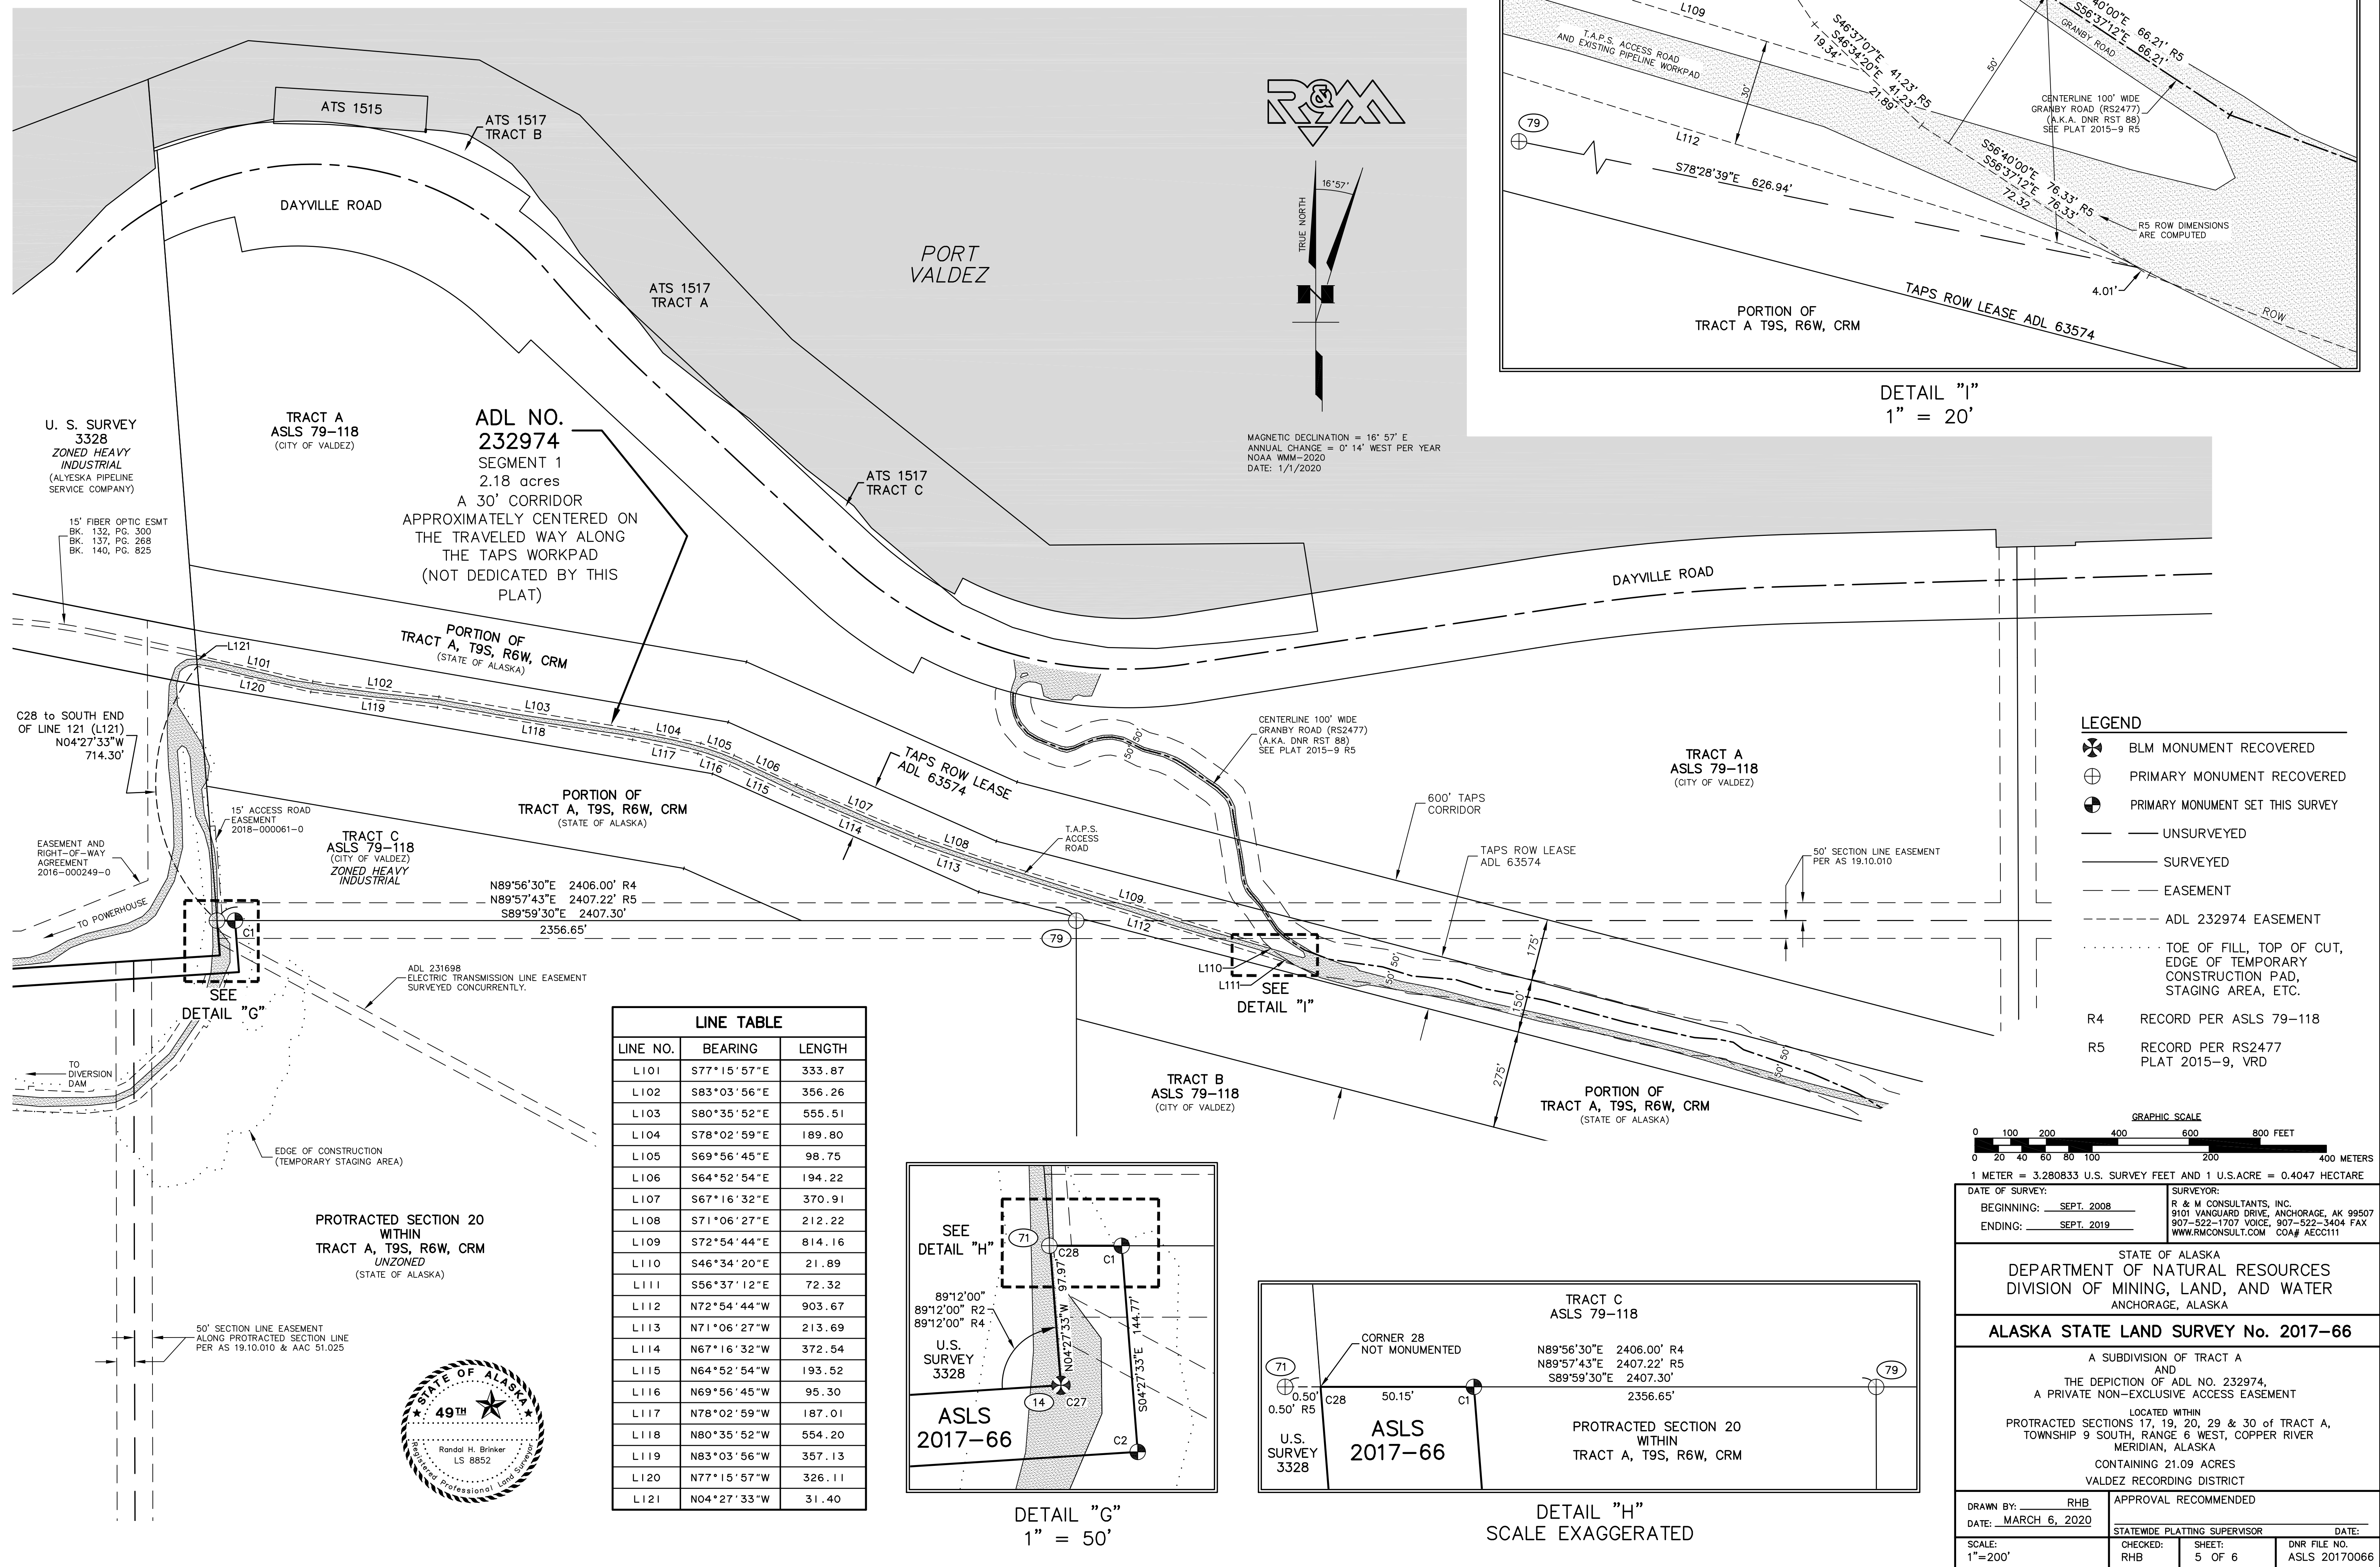


RECOVERED MONUMENTS

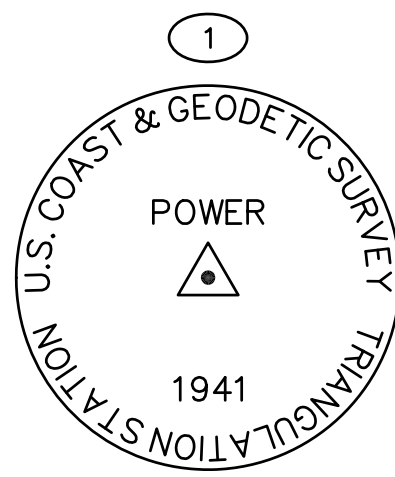


MONUMENT 1
FOUND 3.5" BRASS CAP
FLUSH WITH BEDROCK
CAUTION:
HIGH TIDE WILL COVER

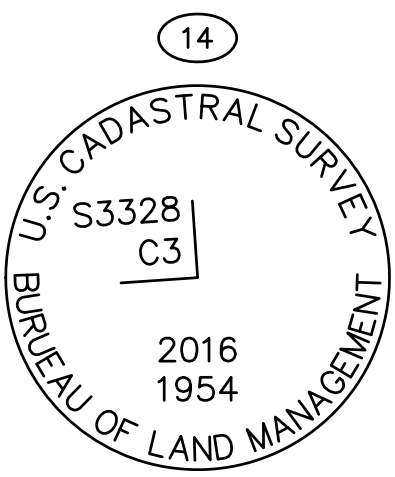


MONUMENT 14 (C27)
FOUND 3.25" BRASS CAP, 0.7' AG,
NOW 0.4' BELOW GRAVEL ROAD
SURFACE.
RESET BY R&M IN 2016.
REFERENCE: ROM 2016-000631-0
RECOVERED ACCESSORY
BT 36" SPRUCE S82°53'W 84.2'
(R2 6" SPRUCE S80°W 84.5)
SET ACCESSORIES
RM1 N04°27'33"W 10.01'
RM2 N04°27'33"W 20.80'

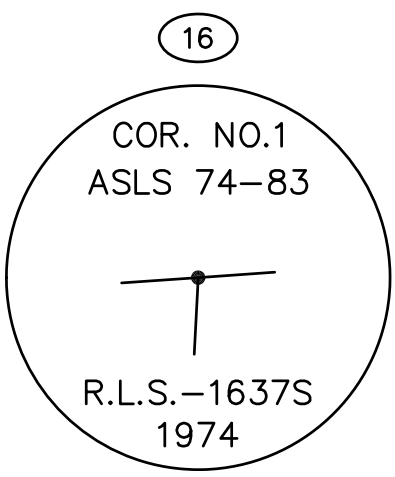


MONUMENT 16
FOUND 3" ALUM. CAP,
0.4' AG

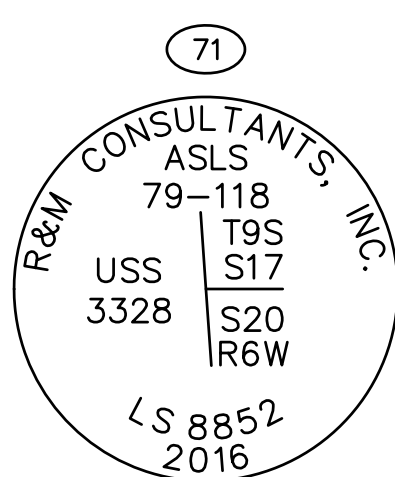


MONUMENT 71 (NEXT TO C28)
FOUND 2.5" ALUM. CAP (1980), 1.0' BG
DESTROYED BY CONSTRUCTION
RESET 2.5"x30" IRON POST,
FLARED AT BASE W/ 3.25" BRASS
CAP (2016).
REFERENCE: ROM 2016-000630-0
SET ACCESSORIES FROM 71
RM1 S89°59'30"E 15.00'
RM2 S89°59'30"E 30.00'
SAME ACCESSORIES FROM C28
RM1 S89°59'30"E 14.50'
RM2 S89°59'30"E 29.50'

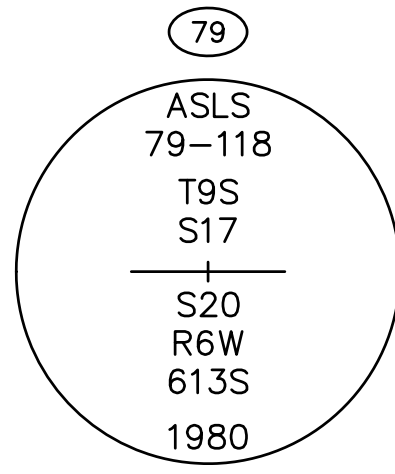


MONUMENT 79
FOUND 2.5" ALUM. CAP
0.3' BG

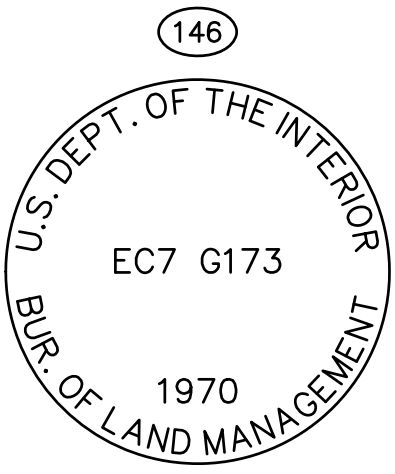


MONUMENT 146
FOUND 3.25" BRASS CAP
0.4' AG

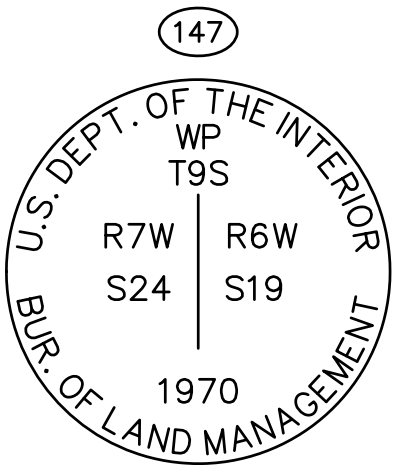

MONUMENT 147
FOUND 3.25" BRASS CAP
0.4' AG

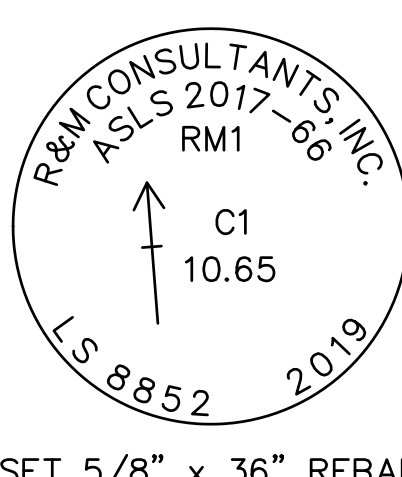


SET 5/8" x 36" REBAR
WITH 2" ALUM. CAP
NOTE:
MANY RM'S FELL ON BOULDERS OR MET
REFUSAL BEFORE REACHING 36" REBAR
DEPTH. IN THESE CASES, THE REBAR WAS
CUT AND EPOXYED INTO THE BOULDER, OR
CUT OFF AT GROUND LEVEL WHEN REFUSAL
WAS MET.

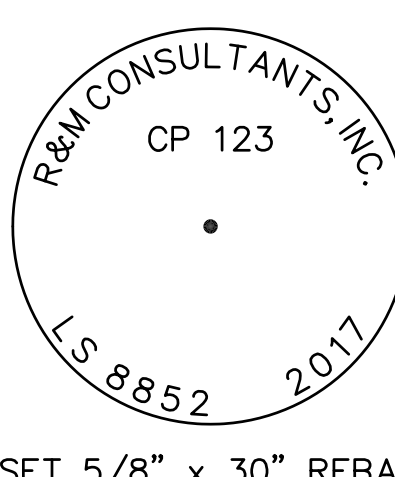


SET 5/8" x 30" REBAR
WITH 2" ALUM. CAP
NOTE:
CONTROL POINTS (CP'S) WERE SET ON
VARIOUS DATES BETWEEN 2011 & 2019


SET ASLS 2017-66 CORNERS

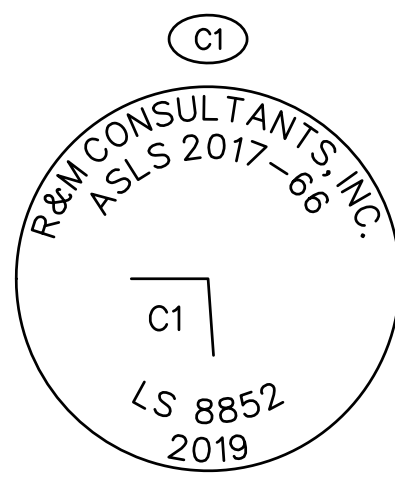


MONUMENT C1
SET 2.5"x30" ALUM. POST,
FLARED AT BASE,
W/ 3.25" ALUM. CAP FLUSH
SET ACCESSORIES
RM1 S04°27'33"E 10.65'
RM2 S04°27'33"E 20.82'
CARS POST 0.6' EAST

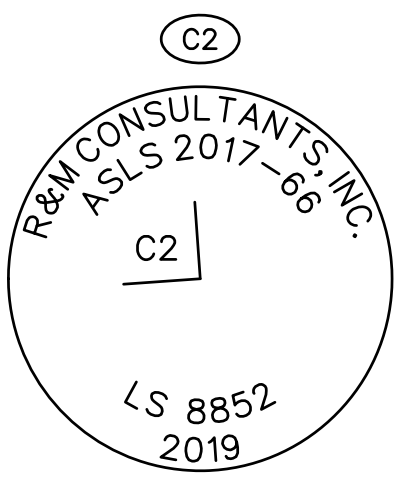


MONUMENT C2
SET 2.5"x30" ALUM. POST,
FLARED AT BASE,
W/ 3.25" ALUM. CAP 0.2' AG
SET ACCESSORIES
RM1 N04°27'33"W 10.35'
RM2 N04°27'33"W 20.85'
CARS POST 0.8' WEST

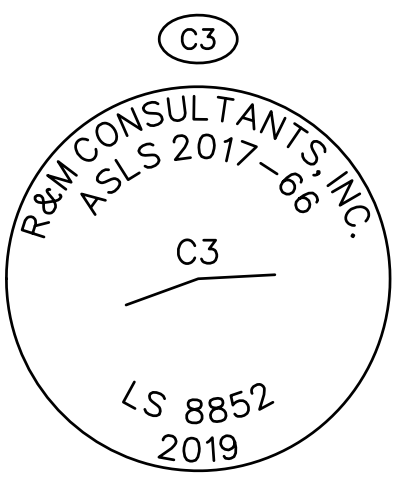


MONUMENT C3
SET 2.5"x30" ALUM. POST,
FLARED AT BASE,
W/ 3.25" ALUM. CAP 0.1' AG
SET ACCESSORIES
RM1 S70°30'07"W 9.19'
RM2 S70°30'07"W 20.24'
CARS POST 0.7' SOUTH

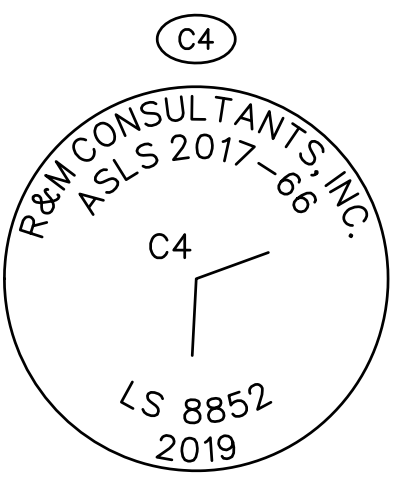


MONUMENT C4
SET 2.5"x30" ALUM. POST,
FLARED AT BASE,
W/ 3.25" ALUM. CAP FLUSH
SET ACCESSORIES
RM1 N70°30'07"E 10.43'
RM2 N70°30'07"E 20.93'
CARS POST 0.7' SOUTH

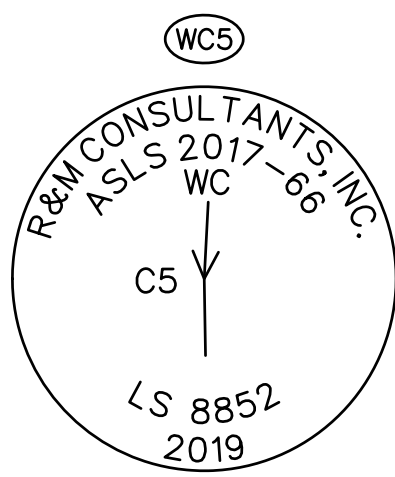


MONUMENT WC5
SET 5/8"x10" REBAR IN
BOULDER 1.0' BG
W/ 2.5"x4" ALUM. POST,
CRIMPED AND EPOXYED ON
REBAR W/ 3.25" ALUM. CAP
0.4' BG
SET ACCESSORIES
RM1 N03°09'32"E 9.99'
RM2 N03°09'32"E 20.85'
CARS POST 0.8' NORTH

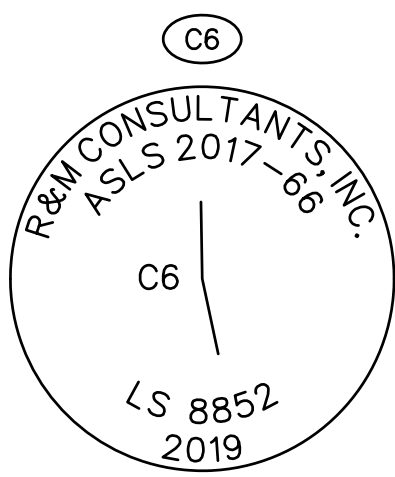


MONUMENT C6
SET 2.5"x30" ALUM. POST,
FLARED AT BASE,
W/ 3.25" ALUM. CAP 0.2' AG
SET ACCESSORIES
RM1 N15°13'09"W 9.40'
RM2 N15°13'09"W 17.92'
CARS POST 0.6' SOUTH
NOTE: RM'S INADVERTENTLY
SET ON LINE C6-C23

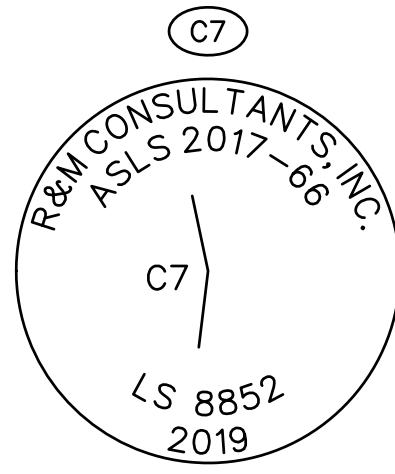


MONUMENT C7
SET 2.5"x30" ALUM. POST,
FLARED AT BASE,
W/ 3.25" ALUM. CAP 0.1' AG
SET ACCESSORIES
RM1 N12°03'09"W 10.47'
RM2 N12°03'09"W 20.81'
CARS POST 0.7' SOUTH

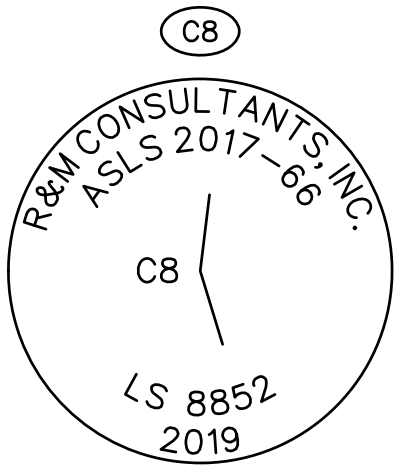


MONUMENT C8
SET 2.5"x30" ALUM. POST,
FLARED AT BASE,
W/ 3.25" ALUM. CAP 0.3' BG
SET ACCESSORIES
RM1 S17°28'11"E 9.85'
RM2 S17°28'11"E 21.38'
CARS POST NONE (MON
FALLS IN CENTER OF ACCESS
ROAD)

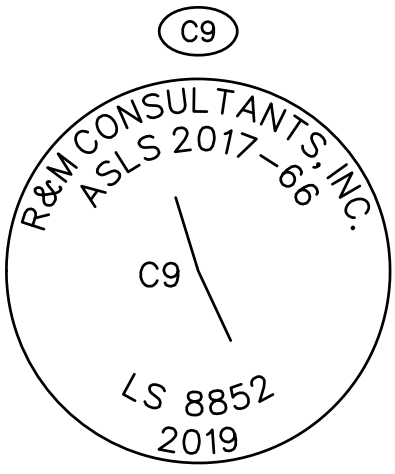


MONUMENT C9
SET 2.5"x30" ALUM. POST,
FLARED AT BASE,
W/ 3.25" ALUM. CAP 0.4' AG
WITHIN 4' DIAMETER CAIRN
SET ACCESSORIES
RM1 N17°28'11"W 8.70'
RM2 N17°28'11"W 19.15'
CARS POST 0.5' NE

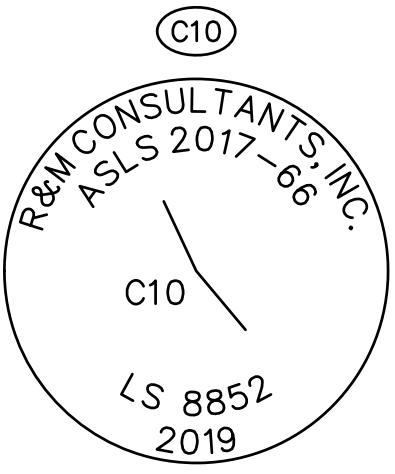


MONUMENT C10
SET 2.5"x30" ALUM. POST,
FLARED AT BASE,
W/ 3.25" ALUM. CAP 0.1' AG
SET ACCESSORIES
RM1 N25°23'49"W 10.20'
RM2 N25°23'49"W 21.00'
CARS POST 0.5' EAST

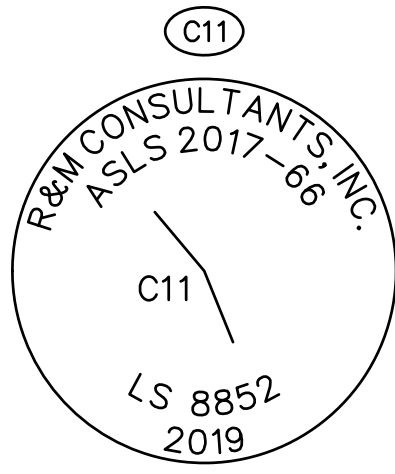


MONUMENT C11
SET 5/8"x7" REBAR, EPOXYED
IN BOULDER 0.6' BG
W/ 3.25" ALUM. CAP 0.3' BG
SET ACCESSORIES
RM1 N39°57'05"W 9.99'
RM2 N39°57'05"W 22.31'
CARS POST 0.6' SE

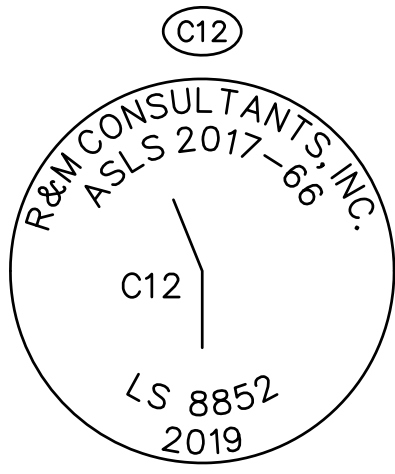


MONUMENT C12
SET 2.5"x30" ALUM. POST,
FLARED AT BASE,
W/ 3.25" ALUM. CAP 0.1' AG
SET ACCESSORIES
RM1 S00°20'00"W 10.52'
RM2 S00°20'00"W 20.73'
CARS POST 0.6' SOUTH

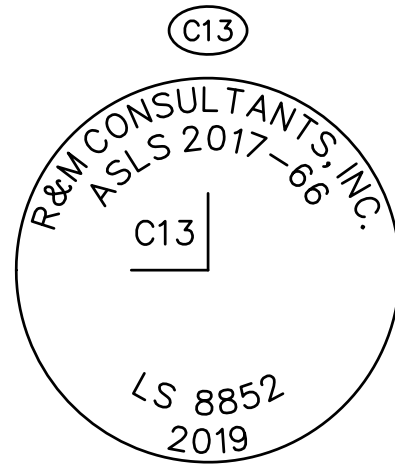


MONUMENT C13
SET 2.5"x30" ALUM. POST,
FLARED AT BASE,
W/ 3.25" ALUM. CAP FLUSH
WITHIN 2'X3' CAIRN WEDGED
BETWEEN BOULDERS
SET ACCESSORIES
RM1 N00°20'00"E 10.48'
RM2 N00°20'00"E 20.96'
CARS POST 0.6' SE

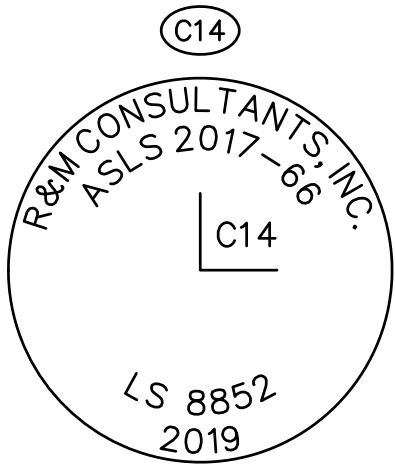


MONUMENT C14
SET 2.5"x30" ALUM. POST,
FLARED AT BASE,
W/ 3.25" ALUM. CAP 0.4' AG
SET ACCESSORIES
RM1 S89°40'00"E 14.15'
RM2 S89°40'00"E 25.81'
CARS POST 1.0' SW

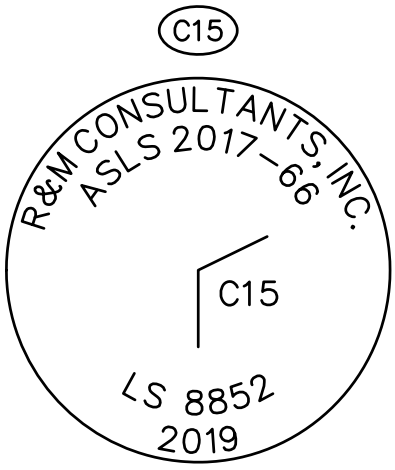


MONUMENT C15
SET 2.5"x30" ALUM. POST,
FLARED AT BASE,
W/ 3.25" ALUM. CAP 0.2' AG
SET ACCESSORIES
RM1 N64°08'05"W 10.30'
RM2 N64°08'05"W 21.36'
CARS POST 1.0' NORTH

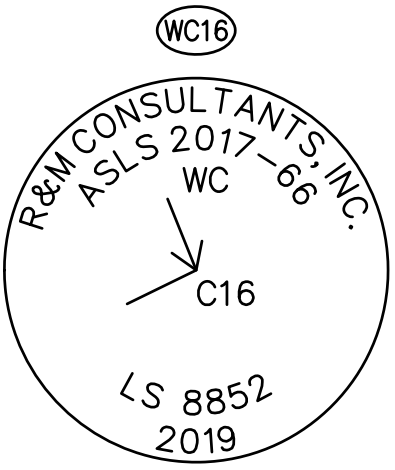


MONUMENT WC16
SET 2.5"x30" ALUM. POST,
FLARED AT BASE,
W/ 3.25" ALUM. CAP 0.2' AG
SET ACCESSORIES
RM1 N21°32'39"W 10.17'
RM2 N21°32'39"W 20.07'
CARS POST 0.8' NW

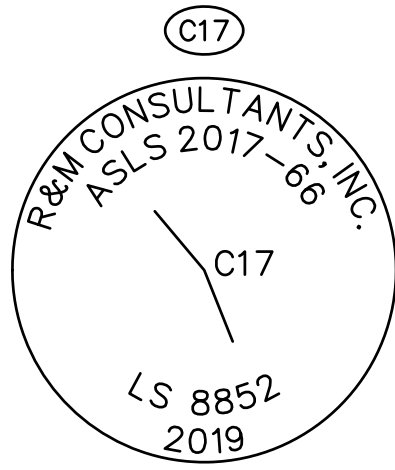


MONUMENT C17
SET 5/8"x6" REBAR 3' AG
EPOXYED IN 8' DIAMETER
BOULDER
W/ 3.25" ALUM. CAP 0.2'
ABOVE BOULDER
SET ACCESSORIES
RM1 N39°57'05"W 10.16'
RM2 N39°57'05"W 24.00'
CARS POST 0.7' NORTH

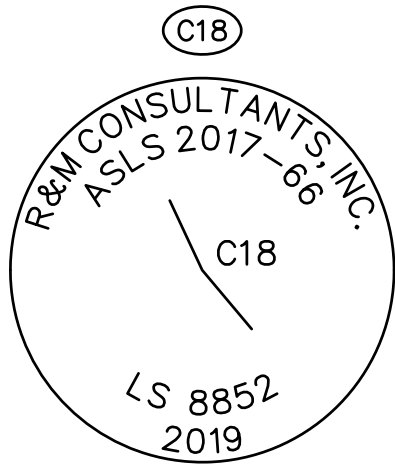


MONUMENT C18
SET 2.5"x30" ALUM. POST,
FLARED AT BASE,
W/ 3.25" ALUM. CAP 1.3' AG,
WITHIN 2'X4' CAIRN
SET ACCESSORIES
RM1 S39°57'05"E 13.30'
RM2 S39°57'05"E 24.65'
CARS POST 1.4' WEST

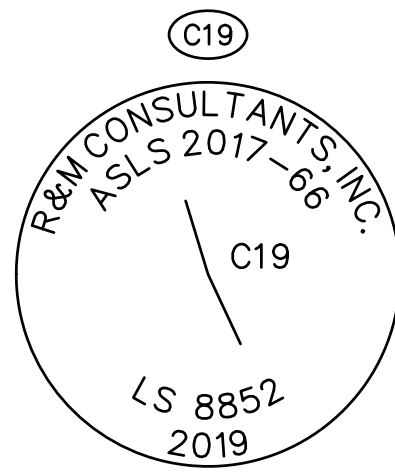


MONUMENT C19
SET 2.5"x30" ALUM. POST,
FLARED AT BASE,
W/ 3.25" ALUM. CAP 0.3' AG
SET ACCESSORIES
RM1 S25°23'49"E 9.93'
RM2 S25°23'49"E 19.55'
CARS POST 0.4' SW

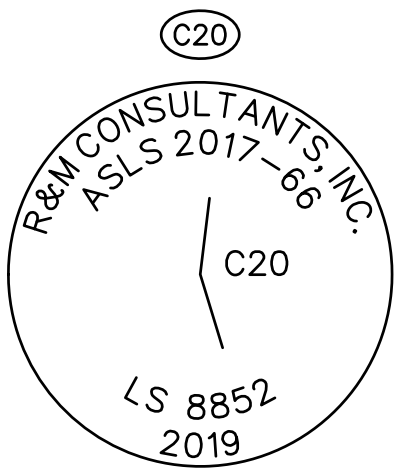


MONUMENT C20
SET 5/8"x26" REBAR
THROUGH CORNER OF
BOULDER, W/ 3.25" ALUM.
CAP EPOXYED 0.2' ABOVE
BOULDER
SET ACCESSORIES
RM1 N06°55'39"E 15.32'
RM2 N06°55'39"E 21.03'
CARS POST 0.6' SE

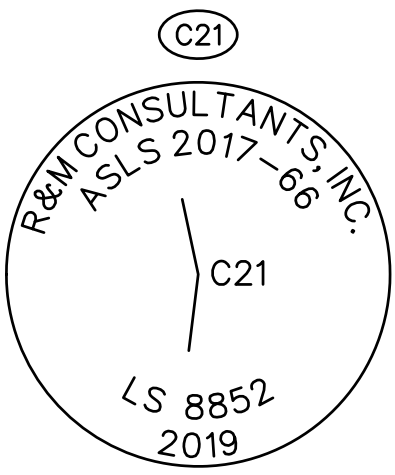


MONUMENT C21
SET 2.5"x30" ALUM. POST,
FLARED AT BASE,
W/ 3.25" ALUM. CAP 0.1' AG
SET ACCESSORIES
RM1 N12°03'09"W 11.24'
RM2 N12°03'09"W 23.92'
CARS POST 1.0' WEST

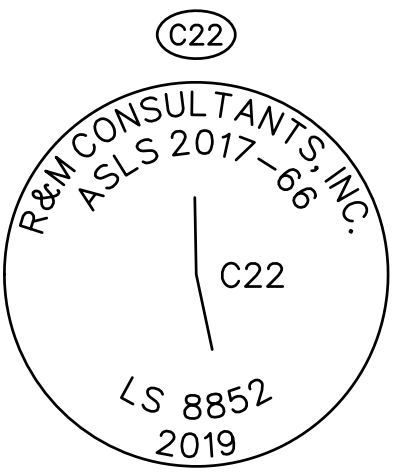


MONUMENT C22
SET 2.5"x30" ALUM. POST,
FLARED AT BASE,
W/ 3.25" ALUM. CAP 0.3' AG
SET ACCESSORIES
RM1 S12°03'09"E 9.48'
RM2 S12°03'09"E 22.42'
CARS POST 0.7' NW

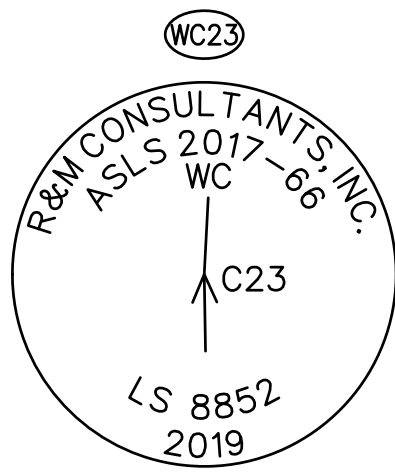


MONUMENT WC23
SET 2.5"x30" ALUM. POST,
FLARED AT BASE,
W/ 3.25" ALUM. CAP FLUSH
SET ACCESSORIES
RM1 S01°13'09"E 10.56'
RM2 S01°13'09"E 20.64'
CARS POST 1.0' NORTH

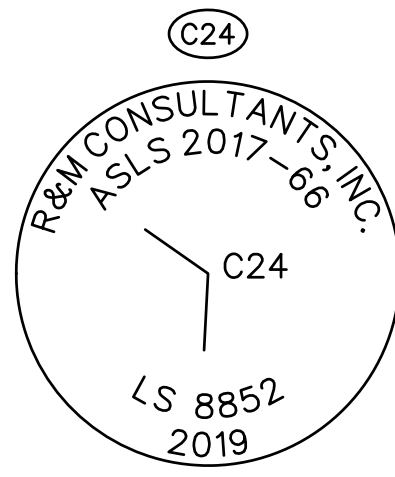

MONUMENT C24
SET 2.5"x30" ALUM. POST,
FLARED AT BASE,
W/ 3.25" ALUM. CAP 0.2' AG
SET ACCESSORIES
RM1 S03°09'32"W 10.28'
RM2 S03°09'32"W 20.88'
CARS POST 0.9' WEST

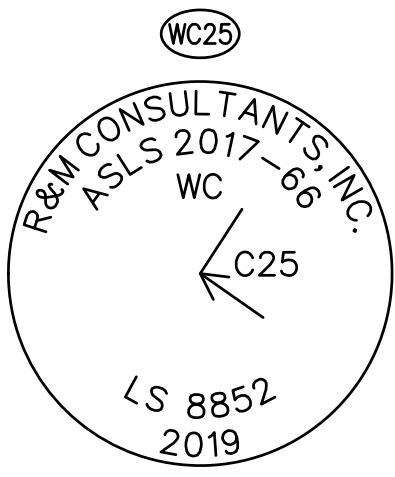

MONUMENT WC25
SET 2.5"x30" ALUM. POST,
FLARED AT BASE,
W/ 3.25" ALUM. CAP 0.4' AG,
WITHIN 2' DIAMETER CAIRN
SET ACCESSORIES
RM1 S54°56'59"E 10.15'
RM2 S54°56'59"E 20.43'
CARS POST 1.0' NW

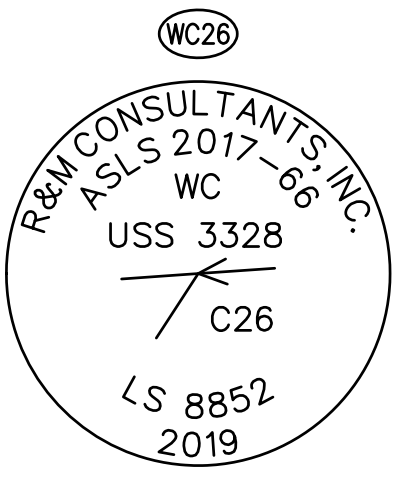

MONUMENT WC26
SET 5/8"x6" REBAR
EPOXYED IN 5' DIAMETER
BOULDER W/ 3.25" ALUM.
CAP 0.3' ABOVE BOULDER
SET ACCESSORIES
RM1 N86°20'27"E 16.05'
RM2 N86°20'27"E 24.31'
CARS POST 0.7' NW

C27

MONUMENT C27
SAME AS RECOVERED
MONUMENT NO. 14.
SEE ABOVE.

C28

CORNER 28
CORNER 28 IS NOT MONUMENTED.
CORNER 28 IS S89°59'30"E 0.50' FROM
RECOVERED MONUMENT NO. 71.
SEE ABOVE RECOVERED MONUMENT NO. 71.
SEE DETAIL H, SHEET 5



DATE OF SURVEY: BEGINNING: SEPT. 2008 ENDING: SEPT. 2019		SURVEYOR: R & M CONSULTANTS, INC. 9101 VANGUARD DRIVE, ANCHORAGE, AK 99507 907-522-1707 VOICE, 907-522-3404 FAX WWW.RMCONSULT.COM COA# AECC111	
STATE OF ALASKA DEPARTMENT OF NATURAL RESOURCES DIVISION OF MINING, LAND, AND WATER ANCHORAGE, ALASKA			
ALASKA STATE LAND SURVEY No. 2017-66			
A SUBDIVISION OF TRACT A AND THE DEPICTION OF ADL NO. 232974, A PRIVATE NON-EXCLUSIVE ACCESS EASEMENT LOCATED WITHIN PROTRACTED SECTIONS 17, 19, 20, 29 & 30 of TRACT A, TOWNSHIP 9 SOUTH, RANGE 6 WEST, COPPER RIVER MERIDIAN, ALASKA CONTAINING 21.09 ACRES VALDEZ RECORDING DISTRICT			
DRAWN BY: RHB DATE: MARCH 6, 2020		APPROVAL RECOMMENDED STATEWIDE PLATTING SUPERVISOR DATE:	
SCALE: 1"=200'	CHECKED: RHB	SHEET: 6 OF 6	DNR FILE NO. ASLS 20170066