


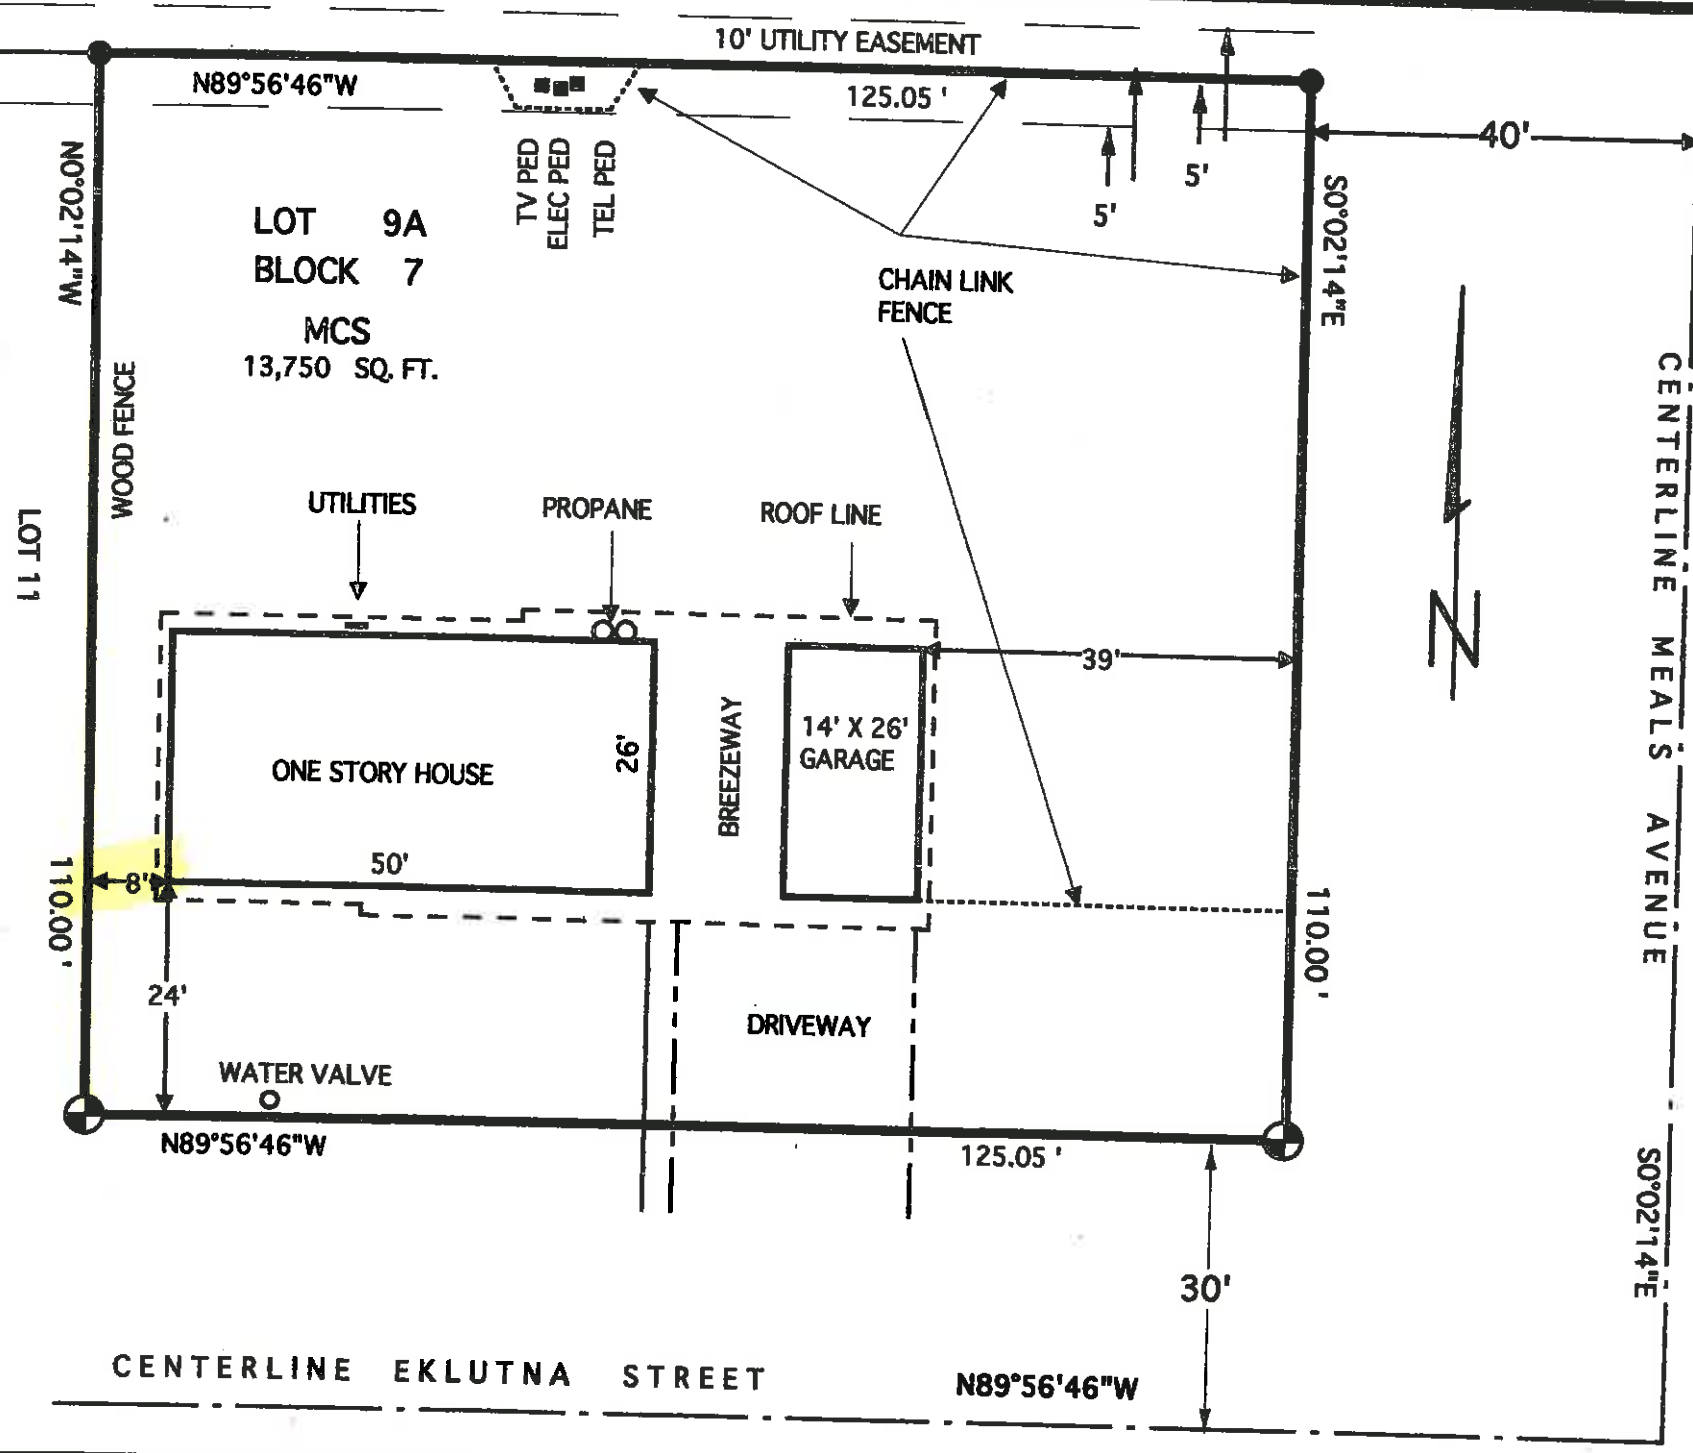


LEGEND

- REBAR FOUND
- ⊕ REBAR SET
- CHAIN LINK FENCE

SURVEYOR'S CERTIFICATE

I, TERRY GILMORE, HEREBY CERTIFY THAT I AM A REGISTERED LAND SURVEYOR IN THE STATE OF ALASKA AND THAT THIS DRAWING REPRESENTS A SURVEY MADE BY ME AND THAT ALL MONUMENTS, DIMENSIONS AND OTHER DETAILS SHOWN ARE CORRECT TO THE BEST OF MY KNOWLEDGE.

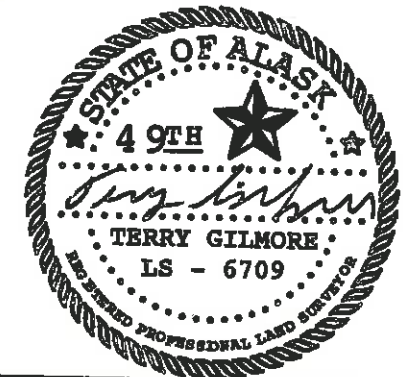

GILMORE and ASSOCIATES H. C. 60 BOX 216 COPPER CENTER, ALASKA 99573	
PREPARED FOR GLORIA McALISTER FOR KATIE DEWING P. O. BOX 814 VALDEZ, ALASKA 99686	
AN AS-BUILT SURVEY OF LOT 9 A, BLOCK 7 MINERAL CREEK SUBDIVISION VALDEZ, ALASKA	
VALDEZ RECORDING DISTRICT	
SCALE 1" = 20'	DATE 8-03-07