


AS-BUILT SURVEY

BLACKGOLD SUBDIVISION, BLOCK 3, LOT 5

#12045

PARK STRIP

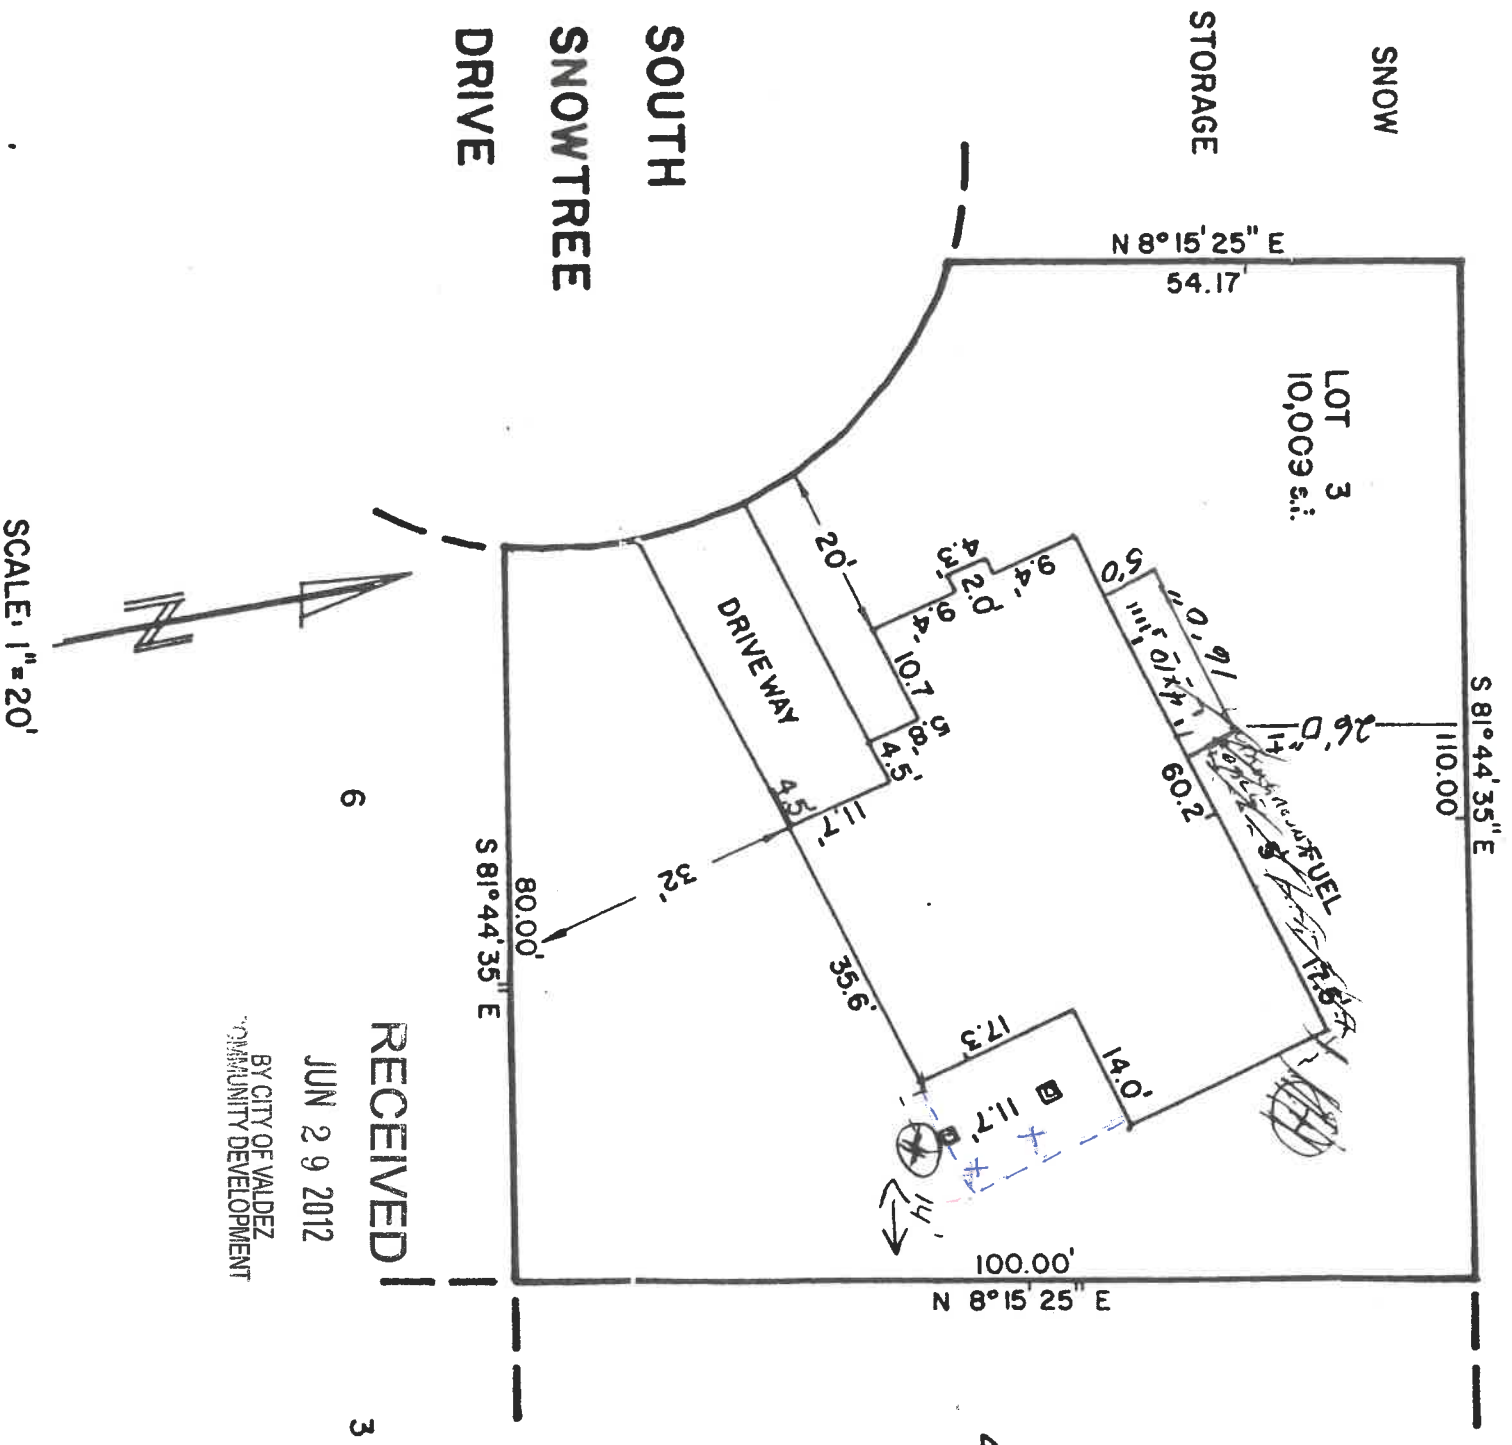

I hereby certify that I have surveyed the following described property;

Lot 5, Bk 3, Black Gold No. 1 Subdivision and that the improvements situated thereon are within the property lines and do not overlap or encroach on the property lying adjacent thereto, that no improvements on property lying adjacent thereto encroach on the premises in question and that there are no roadways, transmission lines or other visible easements on said property except as indicated hereon.

Dated at Valdez Aka this 19th of Nov. 1991

Signed:

~~Clyde E. Ruhl~~
No. LS 3098

